#150 #47000 MB

THIS PERMIT VOIDS PREVIOUS ISSUED TO SALLY HOMOLA 10-12-95

# IREDELL COUNTY HEALTH DEPARTMENT

STATESVILLE 704-878-5305 MOORESVILLE 704-664-5281

622212

## IMPROVEMENT PERMIT / CERTIFICATE OF COMPLETION / OPERATION PERMIT / EXISTING SYSTEM INSPECTION

PROPERTY DESCRIPTION NO. 24537 DATE 7-25-96 TAX MAP NO. 10B-1-F-8 Watershed: ☐ Yes ☒ No

OWNER OR CONTRACTOR KENNETH A. WATT PHONE: Business Home 876-0047

ADDRESS 129 BECKHAM ROAD, STATESVILLE NC 28677

LOCATION US 21 N, TR JANE SOWERS RD, TR FRIAR TUCK TL MARIAN, 1ST ON LEFT PAST OWNER

SUBDIVISION SHERWOOD FOREST BLOCK / SECTION LOT 6 LOT AREA 0.512 AC SITE CLASS. PS DESIGN FLOW 360 L.T.A.R. 0.25 GPD/FT²

Septic Tank: 1000 Gallons; STB 1012 Date 9-21-96

Pump Tank: Gallons; PT Date

Pump Make: Model Serial No.

Nitrification Field: No Fields 1 Square Feet FR. TO 1440 Linear Feet 360+

No Lines 4 Trench Width 36" Max Trench Bottom Depth 36" Gravel Depth N/A

☒ New System ☐ Repair, System Type: I, II, (III) IV, V, VI

System Description: CHAMBERED GRAVITY

Repair System Description: PPBPS GRAVITY

Maintenance Agreement Required: ☐ Yes ☒ No

☒ House/Mod. Home No. Bedrooms 3

☐ Mobile Home No. Bathrooms 2

☐ Business No. Employees

☐ Other


☐ Slab ☒ Crawl Space ☐ Basement w/plumbing ☐ Basement wo/plumbing

Water Supply: ☐ Individual ☐ Community ☒ Public


Comments: INSTALL 60 CHAMBERS IN FOUR LINES AS SHOWN

Comments:

INITIAL SITE SKETCH

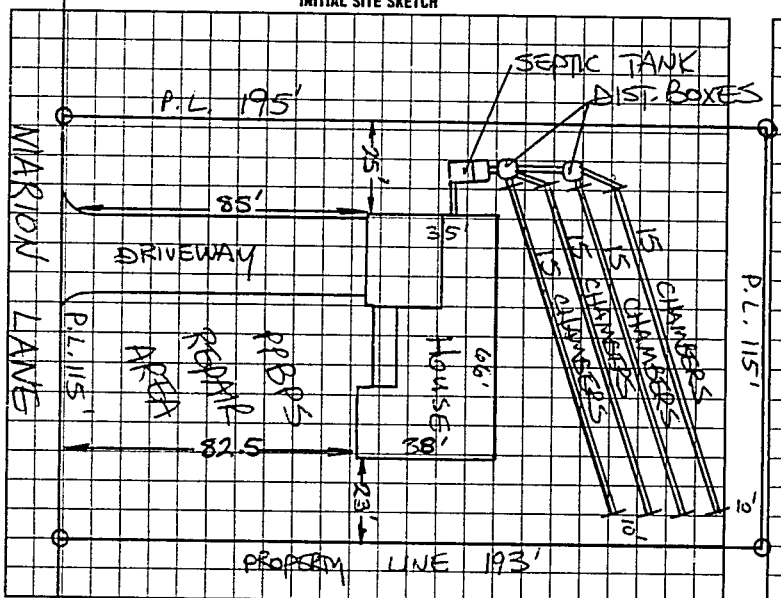


AS BUILT SKETCH

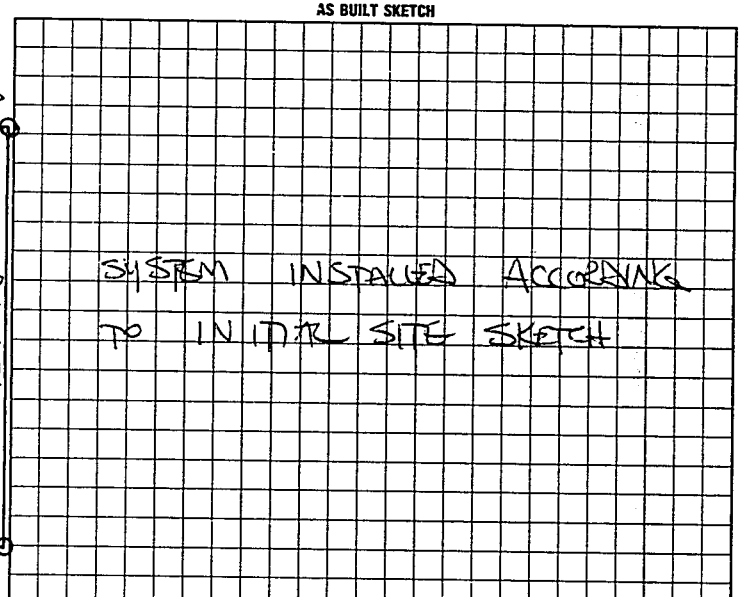


I understand that this permit can be suspended or revoked if any false information is supplied toward securing the permit/any unauthorized changes are made to the site/any unauthorized changes are made in the installation of the system.

AUTH. TO CONST. IS VALID FIVE (5) YEARS FROM DATE OF ISSUANCE. IMPROVEMENT PERMIT W/ SITE PLAN IS VALID FOR FIVE YEARS.

Signed: Kenneth A Watt

Improvement Permit by: STEVE HEDRICK date 7-25-96

~~Auth. To Const.~~ Existing System Inspection by: STEVE HEDRICK date 7-25-96

Installed by: DAVID YOUNTS

~~Certificate of Completion by:~~ date

Operation Permit by: STEVE HEDRICK date 12-16-96

HEALTH DEPT. COPY: WHITE INSPECTION COPY (FINAL): GREEN OWNER COPY (FINAL): YELLOW INSPECTION COPY (INITIAL): PINK OWNER COPY (INITIAL): GOLD