Statesville Phone TR 3-7271

IREDELL COUNTY HEALTH DEPARTMENT

Mooresville Phone NO 3-1271

PERMIT TO INSTALL SEPTIC TANK

Permit No. 258 Mitchell

Permit Date 10-15 1971

Owner Blvr. PAUL MUNDAY Address STATESVILLE, N.C

Installed By YORK RUFTY Address Stony Point, N.C

Location of Property SHERWOOD FOREST - ROAD # 2189 ON RIGHT


Tank		Capacity		Length of Lines		Fixtures	
Block	( )	1000	(✓)	225'	( )	No. of Baths	(1½)
Precast	(✓)	1250	( )	250'	( )	Dishwasher	( )
		1500	( )	Other 240 Sq. Ft.		Garbage Grdr.	( )
		Other				Other	

NOTIFY HEALTH DEPARTMENT AT LEAST EIGHT HOURS BEFORE TANK IS TO BE INSPECTED.

Final Inspection 10-15 1971

Approved (✓) Disapproved ( )

Remarks

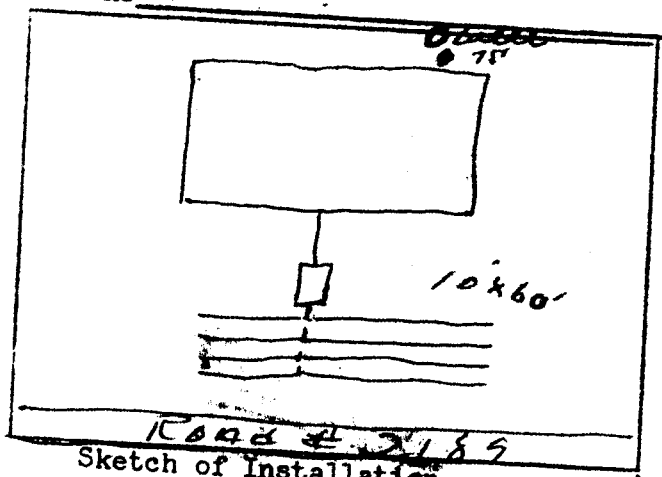

Sketch of Installation

Poor Soil Condition
Maybe Fill Dirt.
(Extra Gravel)

Glenn Todd

Sanitarian