REPAIR PIN- 4746-64-1050 05WP- 2023-39548

APPLICANT/OWNER: LENTZ WASTE WATER APPLICANT ADDRESS: 463 LENTZ ROAD, STATESVILLE, N.C. 28625

SITE ADDRESS: 109 ROBINHOOD LOOP, STATESVILLE, N.C. 28625 PHONE: 704-682-4421 ALT. PHONE 980-635-3471


SITE DIRECTIONS: (N) ON 21, (R) ON JANE SOWERS, (L) ON ROBINHOOD, LOT ON (L) SAP CONTROLLED: ☐ YES ☐ NO

SUBDIVISION: SHERWOOD FOREST DEVELOPMENT SECTION: - LOT # 6 LOT AREA: 0.652 AC DESIGN FLOW: EXT L.T.A.R.: EXT

Septic Tank	1000	(gal)	STB	760	Date	9-9-23	☐ New System	☑ Repair	☐ Expansion	System Type: I II III IV V VI	☑ Residence	No. Bedrooms	EXT	Water Supply
Pump Tank	-	(gal)	PT	-	Date	-	System Description:	EXISTING CONVENTIONAL			☐ Business	No. Persons	EXT	☐ Private
Pump Make	-		Model	-	Serial #	-	Repair System Description:	TANK REPLACEMENT			☐ Other	No. Employees	-	☑ Public
# Nitrification Fields	EXT	# Lines	EXT		Linear Ft	EXT	Maintenance Agreement Required:	☐ YES	☑ NO		☐ Slab	☐ Crawl Space		☐ Community
Trench Width	EXT	Trench Bottom Depth(Low side)	EXT		Gravel Depth			☑ GRAVITY	☐ PRESSURE		☑ Basement w/plumbing		☐ Basement w/o plumbing	

Comments / Conditions: PUMP, CRUSH, AND FILL EXISTING SEPTIC TANK, INSPECT AND REPLACE DISTRIBUTION AS NEEDED, DRAINFIELD APPEARED TO BE FUNCTIONING AT TIME OF INSPECTION


INITIAL SITE SKETCH

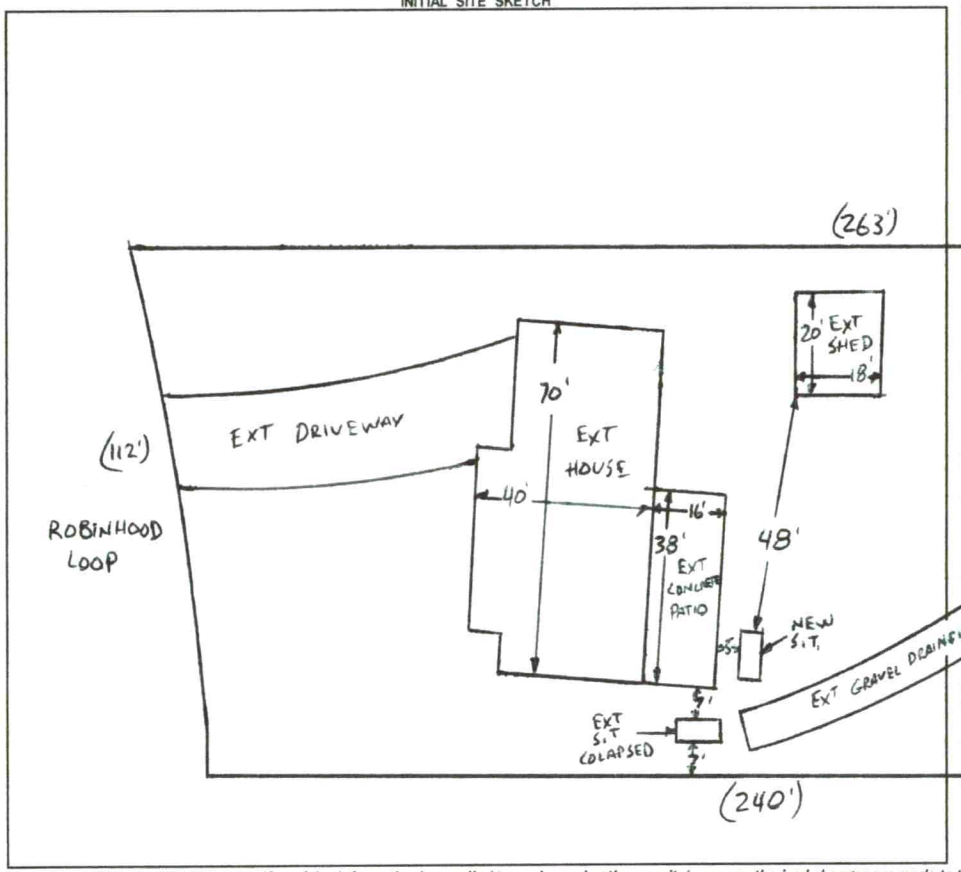

AS BUILT SKETCH

FOR SEPTIC FINAL INSPECTION CALL: 704-664-3703 between 8am-9am the day the inspection is needed. Be sure to speak with an inspector to confirm your time.

1 IN = 40 FT
S.T. = SEPTIC TA
EXT = EXISTING

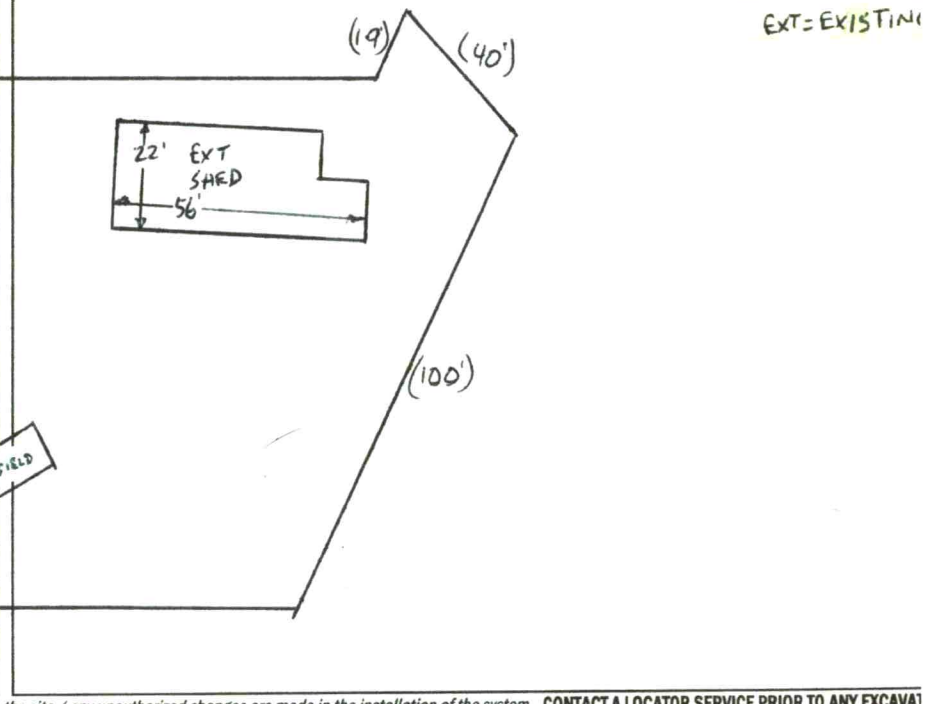

Permit can be suspended or revoked if any false information is supplied toward securing the permit / any unauthorized changes are made to the site / any unauthorized changes are made in the installation of the system. **CONTACT A LOCATOR SERVICE PRIOR TO ANY EXCAVAT**

☐ **IMPROVEMENT PERMIT** *with plat valid without expiration.* ☑ **IMPROVEMENT PERMIT** *with site plan valid for 60 mos.* ☑ **AUTHORIZATION TO CONSTRUCT** *valid for period equal to IMPROVEMENT PERMIT--not to exceed 60*

Owner / Applicant Signature: ONLINE SIGNATURE Date: - Installed by: Lentz

IMPROVEMENT PERMIT by: Bryant C. White Date: 10-31-2023 OPERATION PERMIT by: Sydney Howard Date: 11/6/23

AUTHORIZATION TO CONSTRUCT by: Bryant C. White Date: 10-31-2023 Existing System Inspected by: Date:

FOR SEPTIC FINAL INSPECTION: CALL 704-664-3703 between 8am-9am the day the inspection is needed.

Item	Date	Initials
Drain Lines Checked		
Tanks Checked		
Pressure Manifold or Valve Box Checked		
Pressure Head Set		
Electrical Checked		
Floats Set		
Alarm Checked		
Maintenance Contract Needed? Y / N		
Comments:		

Repairs Only	
	State Code
Failing System Code	
Type of Distribution	G or P
Type of Failure/Malfunction	
Primary Cause of Failure/Malfunction	
Age of System? _____	
Initial or Repair? _____	

ICHD - ENVIRONMENTAL HEALTH DIVISION

Statesville Office (704) 878-5305 Mooresville Office (704) 660-3625

PERMIT # DSWP-2023-39548

SEPTIC: IMPROVEMENT PERMIT / AUTHORIZATION TO CONSTRUCT / OPERATION PERMIT / EXISTING SYSTEM

PIN # 4746 -- 64 --1050

APPLICANT/OWNER: LENTZ WASTE WATER

APPLICANT ADDRESS: 463 LENTZ ROAD, STATESVILLE, N.C. 28625

SITE ADDRESS: 109 ROBINHOOD LOOP, STATESVILLE, N.C. 28625

PHONE: 704-682-4421 ALT. PHONE 980-635-3471

SITE DIRECTIONS: (N) ON 21, (R) ON JANE SOWERS, (L) ON ROBINHOOD, LOT ON (L)

SAP CONTROLLED: ☐ YES ☐ ~~NO~~ EXT


SUBDIVISION: SHERWOOD FOREST DEVELOPMENT SECTION: - LOT # 6 LOT AREA: 0.652 AC DESIGN FLOW: EXT L.T.A.R.: EXT

Septic Tank	1000	(gal)	STB		Date		☐ New System	☑ Repair	☐ Expansion	System Type: I (II) III IV V VI	
Pump Tank	-	(gal)	PT	-	Date	-	System Description:	EXISTING CONVENTIONAL			
Pump Make	-	Model		-	Serial #	-	Repair System Description:	TANK REPLACEMENT			
# Nitrification Fields	EXT	# Lines	EXT		Linear Ft	EXT	Maintenance Agreement Required:	☐ YES	☑ NO		
Trench Width	EXT	Trench Bottom Depth(Low side)		EXT	Gravel Depth			☑ GRAVITY	☐ PRESSURE		

☑ Residence	No. Bedrooms	EXT	**Water Supply**
☐ Business	No. Persons	EXT	☐ Private
☐ Other	No. Employees	-	☑ Public
☐ Slab	☐ Crawl Space		☐ Community
☑ Basement w/plumbing		☐ Basement w/o plumbing	


Comments / Conditions: PUMP, CRUSH, AND FILL EXISTING SEPTIC TANK, INSPECT AND REPLACE DISTRIBUTION AS NEEDED, DRAINFIELD APPEARED TO BE FUNCTIONING AT TIME OF INSPECTION

INITIAL SITE SKETCH

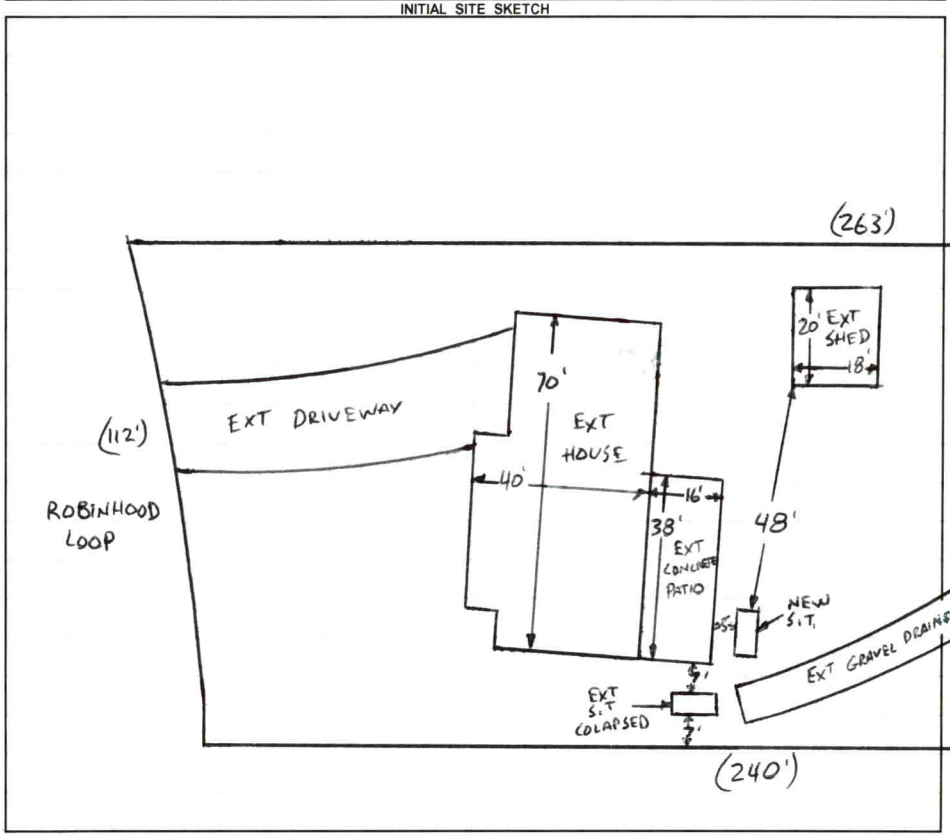

AS BUILT SKETCH

FOR SEPTIC FINAL INSPECTION CALL: 704-664-3703 between 8am-9am the day the inspection is needed. Be sure to speak with an inspector to confirm your time.

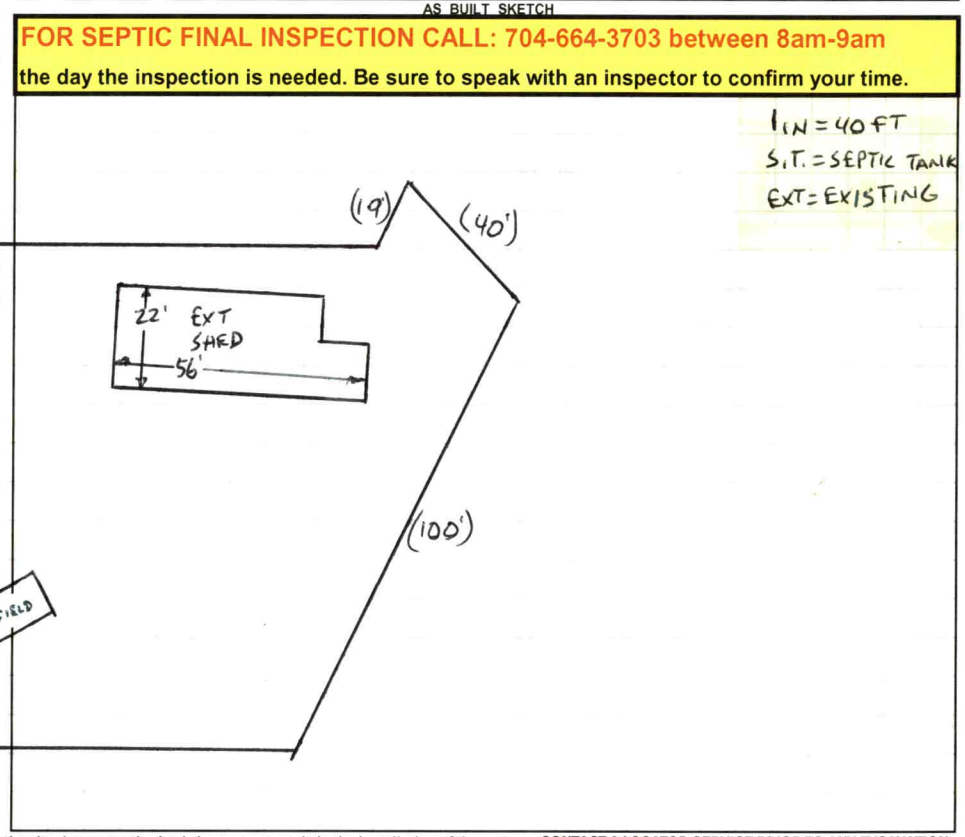

Permit can be suspended or revoked if any false information is supplied toward securing the permit / any unauthorized changes are made to the site / any unauthorized changes are made in the installation of the system. **CONTACT A LOCATOR SERVICE PRIOR TO ANY EXCAVATION**

☐ **IMPROVEMENT PERMIT** ***with plat*** *valid without expiration.* ☑ **IMPROVEMENT PERMIT** ***with site plan*** *valid for 60 mos.* ☑ **AUTHORIZATION TO CONSTRUCT** *valid for period equal to IMPROVEMENT PERMIT--not to exceed 60 mo.*

Owner / Applicant Signature: ONLINE SIGNATURE Date: - Installed by:

IMPROVEMENT PERMIT by: Bryant C. White Date: 10-31-2023 OPERATION PERMIT by: Date:

AUTHORIZATION TO CONSTRUCT by: Bryant C. White Date: 10-31-2023 Existing System Inspected by: Date:

FOR SEPTIC FINAL INSPECTION: CALL 704-664-3703 between 8am-9am the day the inspection is needed.

Item	Date	Initials
Drain Lines Checked		
Tanks Checked		
Pressure Manifold or Valve Box Checked		
Pressure Head Set		
Electrical Checked		
Floats Set		
Alarm Checked		
Maintenance Contract Needed? Y / N		
Comments:		

Repairs Only	
	State Code
Failing System Code	
Type of Distribution	G or P
Type of Failure/Malfunction	
Primary Cause of Failure/Malfunction	
Age of System? _____	
Initial or Repair? _____	


4746-54-9258
4746-65-3949
40
100
150
4746-64-3
4746-53-9919
19
(330)
53
240
4746-64-2072
4746-64-1050
Ext st inlet
115
109
7
110
4746-63-0930
6
112
5
147
126
Robinhood Loop
4746-63-3882
75
4746-63-2717
36
210
32
1 in = 40 ft

PERMIT SNAPSHOT REPORT OSWP-2023-39548 FOR IREDELL COUNTY

Permit Type:	Environmental Health OSWP	**Project:**		**App Date:**	10/19/2023
Work Class:	EH Septic Permit	**District:**	Iredell County	**Exp Date:**	NOT AVAILABLE
Status:	PRIORITY PERMIT	**Square Feet:**	0.00	**Completed:**	NOT COMPLETED
Valuation:	$0.00	**Assigned To:**	White, Bryant	**Approval Expire Date:**	

Description: Septic tank is cracked. Septic tank is uncovered and cracks are visible.

Parcel: 4746641050.000 Main	**Address:** 109 Robinhood Loop Statesville, NC 28625 Main	**Zone:** R-20(Suburban Residential District)

Applicant/Authorized Agent Jeanie Lentz Home: (980) 829-3278	Applicant/Authorized Agent Jeanie Lentz 463 Lentz Road Statesville, NC 28625	Property Owner Lamon Leach Home: (980) 635-3471

Permit Custom Fields

How is your site plan being submitted	Custom Site Plan	Septic Application/Permit Type	Repair	Does the site contain any jurisdictional wetlands	No
Non-domestic Sewage Generated	No	Other Public Agency	No	All proposed structure dimensions	N/A
What are the proposed structures	Other Addition/Structure	Maximum Number of Bedrooms	3	If other Addition/Structure, please explain	
Number of Occupants	3	Foundation Type	Basement with Plumbing	Residential/Business/Other	Residential
Water Supply	Other Public Water	Desired Septic System Type	Conventional (most common)	Additional Unique Setbacks Apply	No


Attachment File Name	Added On	Added By	Attachment Group	Notes
Signature_Jeanie_Lentz_10/19/2023.jpg	10/19/2023 13:33	Lentz, Jeanie		Uploaded via CSS
109 Robinhood Loop Authorization Form_v1.pdf	10/20/2023 8:39	Nebel, Barbara	Available Online	Authorize to Act as Agent
109 robinhood site plan_v1.pdf	10/20/2023 8:39	Nebel, Barbara	Available Online	Site Plan

Workflow Step / Action Name	Action Type	Start Date	End Date
Application Completeness Check v.1		10/20/2023 8:38	10/20/2023 8:39
Confirm application complete v.1	Generic Action		10/20/2023 8:39
Environment Health Inspections v.1			
Operation Permit Inspection v.1	Inspection		
OSWP Alarm Checked v.1	Inspection		
OSWP Drain Lines Checked v.1	Inspection		
OSWP Electrical Checked v.1	Inspection		
OSWP Floats Checked v.1	Inspection		
OSWP Maintenance Contract v.1	Inspection		
OSWP Pressure Head Checked v.1	Inspection		
OSWP Pressure Manifold Checked v.1	Inspection		
OSWP Tanks Checked v.1	Inspection		
Fees v.1			
Issue Invoice v.1	Generic Action		
Fees Paid v.1	Generic Action		
~~**Zoning Review v.1**~~			10/20/2023 8:38
~~Floodplain Admin Overview v.1~~	Task		10/20/2023 8:38
~~Issue Invoice v.1~~	Generic Action		10/20/2023 8:38

PERMIT SNAPSHOT REPORT (OSWP-2023-39548)

~~Fees Paid v.1~~	Generic Action	10/20/2023 8:38
Lot Readiness Verification v.1		
OSWP Septic Preliminary Site Visit v.1	Inspection	
OSWP Site Evaluation v.1	Inspection	
Issue Improvement Permit v.1		
Issue Invoice v.1	Generic Action	
Fees Paid v.1	Generic Action	
Issue Permit v.1	Generic Action	
Permit Completion Process v.1		
Authorization to Construct Permit v.1	Create Sub Permit	
Issue Authorization to Construct v.1	Generic Action	

109 Robinhood Loop

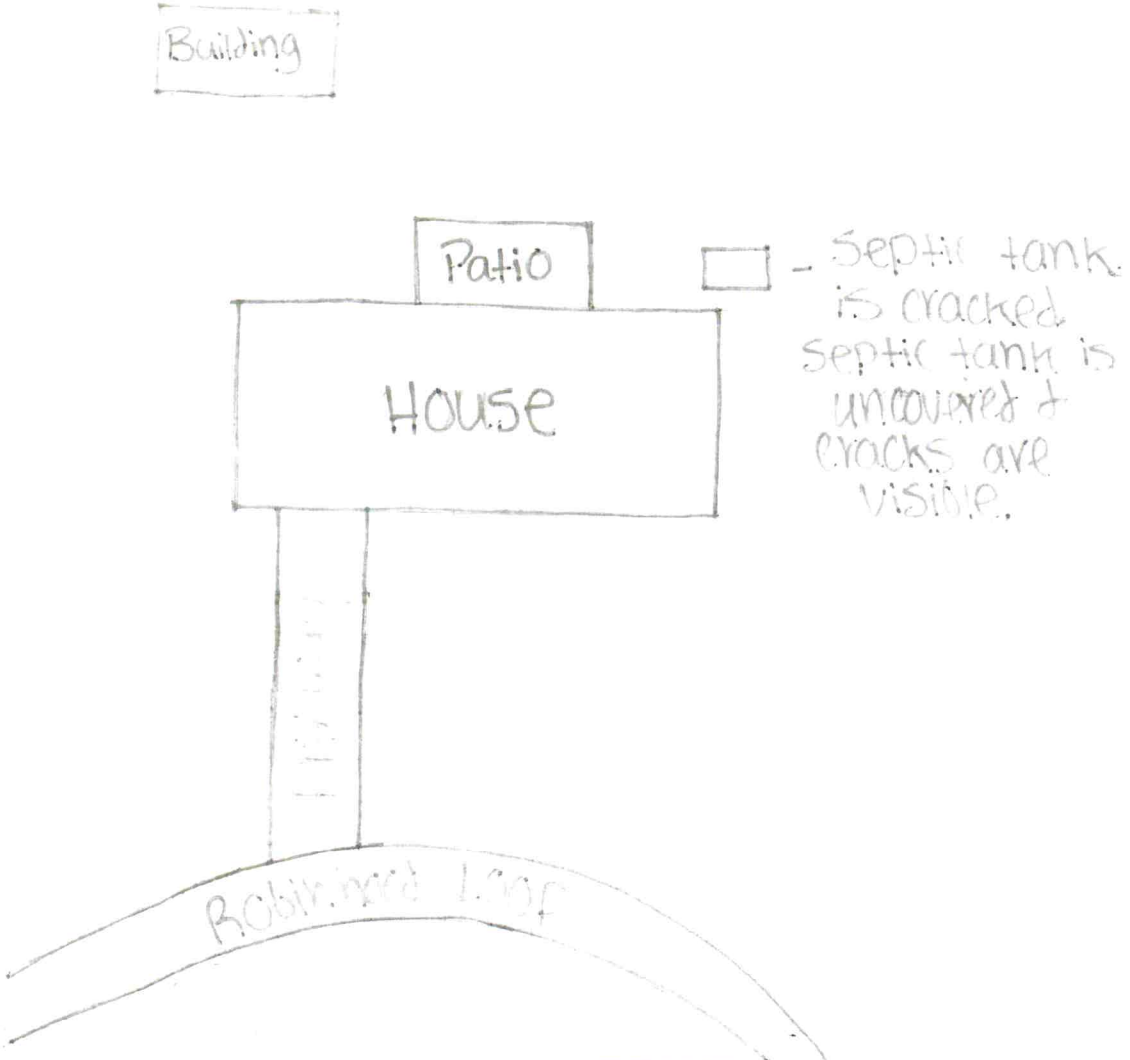

Address: 109 Robinhood Loop STVL
Current HO: Lamon Leach **HO #:** 980-635-3471
# of Bed: 3 **# of Occupants:** 3
Foundation Type: Crawlspace Slab (B/WP) B/WOP
Water supply: (Public) Well **Other:** _____
Year Installed: _____