IREDELL COUNTY HEALTH DEPARTMENT

Statesville Phone TR 3-7271 Mooresville Phone NO 3-1271

PERMIT TO INSTALL SEPTIC TANK

Permit NO. Steadman Building Co. Permit Date Dec 4 1963

Owner Dave Edison Address Sherwood Forest.

Installed By C Hoke Address


Location of Property Robin Hood Rd. Lot no. 8-
Const. # V.A. 102309 Left in Channel 3rd lot on Lft

| Tank | | Capacity | | Length of Lines | | Fixtures | |
|---|---|---|---|---|---|---|---|
| Block | ( ) | 800 | ( ) | 150' | ( ) | No. of Baths | (2) |
| Precast | (→) | 900 | ( ) | 175' | ( ) | Dishwasher | ( ) |
| | | 1000 | (+) | 200' | ( ) | Garbage Grdr. | ( ) |
| | | 1100 | ( ) | 225' | (+) | Auto-Washer | (+) |
| | | 1200 | ( ) | 250' | ( ) | Other | |
| | | Other | | Other | | | |

NOTIFY HEALTH DEPARTMENT AT LEAST EIGHT HOURS BEFORE TANK IS TO BE INSPECTED.

Final Inspection 12-4 1963 Approved (+) Disapproved ( )

Remarks Well 100' Heavy Wooded very deep due to plumbing rough out.

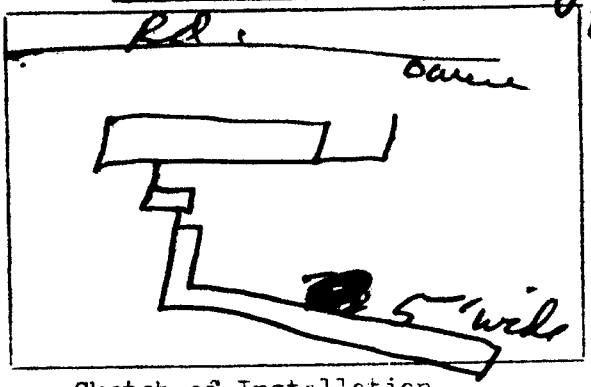


Sketch of Installation

Sanitarian