5:30

IREDELL COUNTY HEALTH DEPARTMENT

STATESVILLE 704-878-5305 MOORESVILLE 704-664-5281

IMPROVEMENT PERMIT / AUTHORIZATION TO CONSTRUCT / OPERATION PERMIT / EXISTING SYSTEM INSPECTION

PERMIT # Repair PIN # 4746-64-5024 DATE 29 April 10

OWNER or APPLICANT Joseph & Traci Burris PHONE: ~~Business~~ Cell (704) 402-7705 Home:

OWNER or APPLICANT ADDRESS 125 Robin Hood Cir. Loop. Statesville.

LOCATION / DIRECTIONS Turnersburg Rd. (210) TR Jane Sowers Rd. TL Robin Hood Lp. - 4th house on left.

SUBDIVISION Sherwood Forest BLOCK / SECTION LOT # 9 LOT AREA DESIGN FLOW 360 g/d L.T.A.R. 0.33 g/ft²/d

Septic Tank Exist. Gallons: STB Date

Pump Tank Gallons: P T Date

Pump Make Model Serial #

Nitrification Field No Fields 1 No Lines 3 Linear Feet 140'

Trench Width 36" Max. Trench Bottom Depth 36" Gravel Depth 24"

☐ New System ☑ Repair ☐ Expansion System Type I II III IV V VI

System Description: Gravel Conventional

Repair System Description:

Maintenance Agreement Required ☐ YES ☑ NO

☑ GRAVITY ☐ PRESSURE


☐ Residence No. Bedrooms 3 ☐ Business No. Persons ☐ Other No. Employees ☐ Slab ☑ Crawl Space ☐ Basement w/plumbing ☐ Basement w/o plumbing

Water Supply: ☑ Private ☐ Public ☐ Community

Comments / Conditions: * Keep 15' From edge of ditch / Keep 5'+ From property line / Keep 5' from building Foundations. Connect to existing system.

Comments / Conditions

INITIAL SITE SKETCH

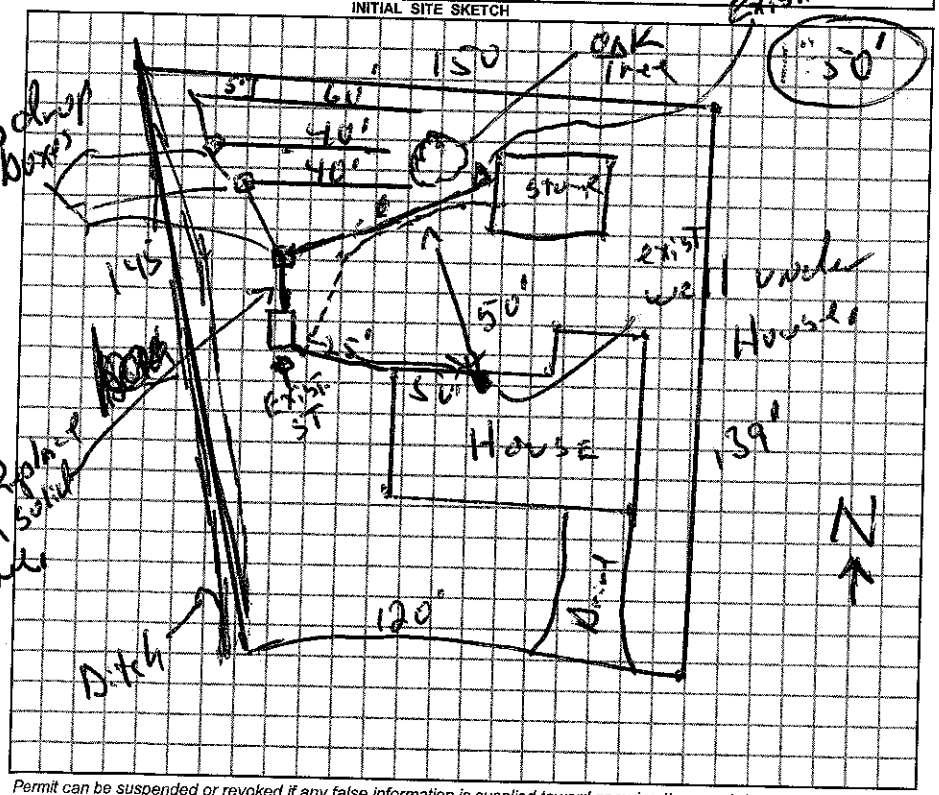

AS BUILT SKETCH

Install as Drawn

Permit can be suspended or revoked if any false information is supplied toward securing the permit / any unauthorized changes are made to the site / any unauthorized changes are made in the installation of the system.

☐ *IMPROVEMENT PERMIT w / plat valid without expiration.* ☐ *IMPROVEMENT PERMIT w / site plan valid for 60 mos.* ☑ *AUTHORIZATION TO CONSTRUCT valid for period equal to IMPROVEMENT PERMIT-not to exceed 60 mo.*

Owner / Applicant Signature: Traci Burris Date 5-14-10

Improvement Permit by: Date

Authorization to Construct by: R.S. Date 30 April 10

Installed by: A-1 Backhoe

Operation Permit by: R.S. Date: 17 June 10

Existing System Inspected by: Date:

YOU SHOULD CONTACT A LOCATOR SERVICE PRIOR TO ANY EXCAVATION.

WHITE COPY Environmental Health YELLOW COPY (Final) Owner / Applicant PINK COPY (Initial) Owner / Applicant