IREDELL COUNTY HEALTH DEPARTMENT

STATESVILLE 704-878-5305 MOORESVILLE 704-664-5281

IMPROVEMENT PERMIT / AUTHORIZATION TO CONSTRUCT / OPERATION PERMIT / EXISTING SYSTEM INSPECTION

PERMIT# 77499 PIN# 4746 66 0676 DATE 11-10-98

OWNER OR CONTRACTOR Robert Current PHONE: Business _____ Home _____

ADDRESS 126 Houpe Rd

LOCATION 21N TL Houpe Rd 1/8 mi Rt

SUBDIVISION _____ BLOCK / SECTION _____ LOT 47 LOT AREA 1.38 acres SITE CLASS PS DESIGN FLOW 360 L.T.A.R. .133

Septic Tank: 1000 Gallons; STB _____ Date _____

Pump Tank: _____ Gallons; PT _____ Date _____

Pump Make: _____ Model _____ Serial No. _____

Nitrification Field: No Fields 1 Square Feet 810 Linear Feet 270

No Lines 3 Trench Width 36" Max Trench Bottom Depth 36" Gravel Depth N/A

[X] New System [ ] Repair System Type: I, II, III, IV, V, VI

System Description: Gravity Chambers

Repair System Description: Pump To Panels

Maintenance Agreement Required: [ ] Yes [X] No

[X] House/Mod. Home No. Bedrooms 3

[ ] Mobile Home No. Bathrooms 2

[ ] Business No. Employees _____

[ ] Other _____

[ ] Slab [ ] Crawl Space [X] Basement w/plumbing [ ] Basement wo/plumbing


Water Supply: [ ] Individual [X] Public [ ] Community

Comments:/Conditions:

Replacing House That Had burned Down House position Does Not meet Current set Back Distances However can't be moved it Still Get system on lot.

Comments:/Conditions:

INITIAL SITE SKETCH

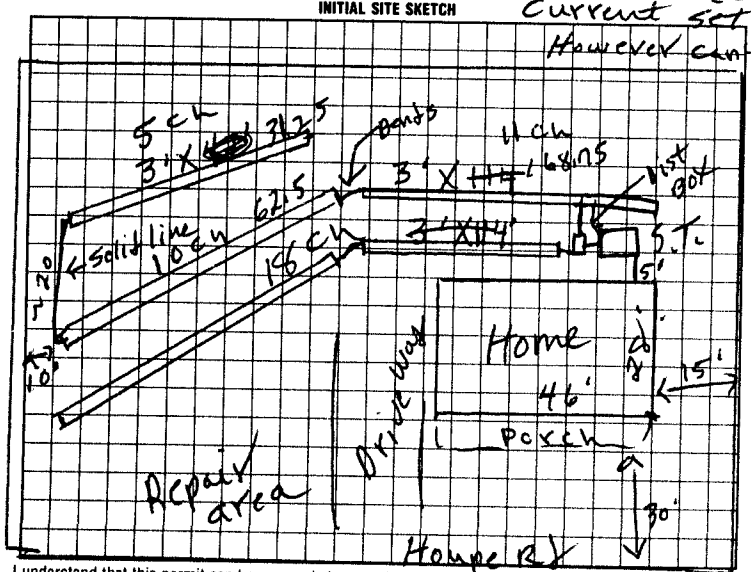

AS BUILT SKETCH

Same as initial Except Lengths are as Shown

Total 44 Chambers

I understand that this permit can be suspended or revoked if any false information is supplied toward securing the permit/any unauthorized changes are made to the site/any unauthorized changes are made in the installation of the system. Improvement Permit with plat valid without expiration. Improvement Permit with site plan valid for sixty months. Authorization to Construct is valid for a period equal to that of Improvement Permit – not to exceed sixty months.

Signed: Robert M. Current date 12-4-98 Installed by: Steve Jarboe

Improvement Permit by: P.C. Moore date 11-10-98 Operation Permit by: P.C. Moore date 2-28-00

Authorization to Construct by: P.C. Moore date 11-10-98 Existing System Inspection by: _____ date _____

HEALTH DEPT. COPY: WHITE INSPECTION COPY (FINAL): GREEN OWNER COPY (FINAL): YELLOW INSPECTION COPY (INITIAL): PINK OWNER COPY (INITIAL): GOLD