IREDELL COUNTY HEALTH DEPARTMENT

STATESVILLE 704-878-5305 MOORESVILLE 704-664-5281

IMPROVEMENT PERMIT / AUTHORIZATION TO CONSTRUCT / OPERATION PERMIT / EXISTING SYSTEM INSPECTION

PERMIT# REPAIR PIN# 4746-70-2920 DATE 4-26-03

OWNER OR CONTRACTOR HAROLD WRIGHT PHONE: Business 704-450-6089 Home 704-873-5435

ADDRESS 355 JAMES FARM ROAD, STATESVILLE NC 28625-2768

LOCATION US 21 NORTH, TR JAMES FARM RD, TL JAMES FARM ROAD, 0.6 MILE ON LEFT

SUBDIVISION _____ BLOCK / SECTION _____ LOT _____ LOT AREA 1.11 ACRES SITE CLASS PS DESIGN FLOW 240 L.T.A.R. EXISTING

Septic Tank: 1000 Gallons; STB _____ Date _____

Pump Tank: _____ Gallons; PT _____ Date _____

Pump Make: _____ Model _____ Serial No. _____

Nitrification Field: No Fields 1 Square Feet 360 Linear Feet 120

No Lines ONE Trench Width 36" Max Trench Bottom Depth 36" Gravel Depth 24"

☐ New System ☑ Repair System Type: I. II. III. IV. V. VI

System Description: _____

Repair System Description: CONVENTIONAL, GRAVITY

Maintenance Agreement Required: ☐ Yes ☑ No

☐ House/Mod. Home ☑ Mobile Home ☐ Business ☐ Other

No. Bedrooms 2 No. Bathrooms 2 No. Employees ____


☐ Slab ☑ Crawl Space ☐ Basement w/plumbing ☐ Basement wo/plumbing

Water Supply: ☑ Individual ☐ Public ☐ Community WELL


Comments/Conditions: ① INSTALL NEW DISTRIBUTION BOX AS SHALLOW AS POSSIBLE FEEDING NEW LINE 1ST. ② INSTALL NEW 3' x 120' LINE AS SHOWN AND FLAGGED ON SITE.

Comments/Conditions:

INITIAL SITE SKETCH

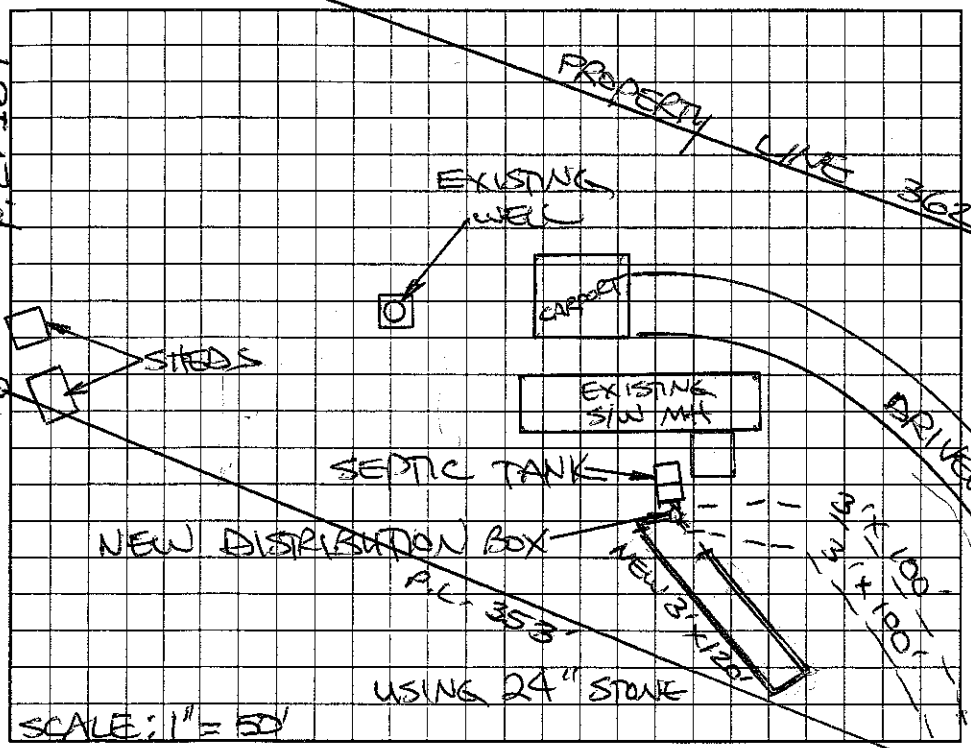

AS BUILT SKETCH

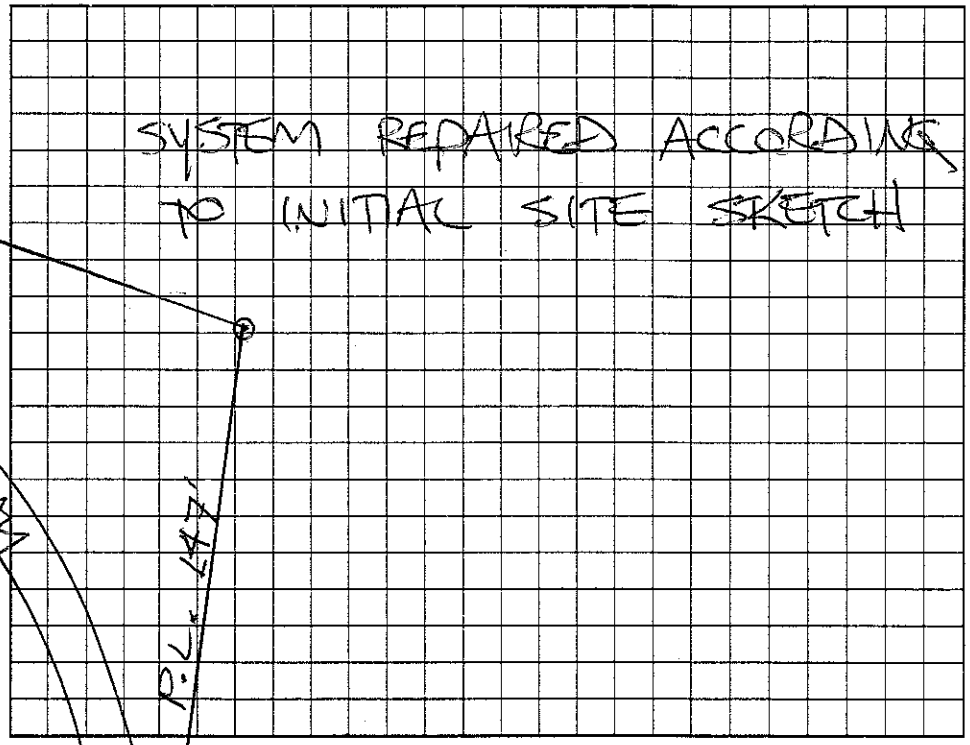

Permit can be suspended or revoked if any false information is supplied toward securing the permit/any unauthorized changes are made to the site/any unauthorized changes are made in the installation of the system. Improvement Permit with plat valid without expiration. Improvement Permit with site plan valid for sixty months. Authorization to Construct is valid for a period equal to that of Improvement Permit – not to exceed sixty months.

Signed: † Harold D. Wright date 4-26-03 Installed by: IREDELL BACKHOE

Improvement Permit by: STEVE HEDRICK date 4-26-03 Operation Permit by: JAMES FARM ROAD STEVE HEDRICK date 4-28-03

Authorization to Construct by: STEVE HEDRICK date 4-26-03 Existing System Inspection by: (SR 2173) date _____

HEALTH DEPT. COPY: WHITE OWNER COPY (FINAL): YELLOW OWNER COPY (INITAL): PINK