(1)

IREDELL COUNTY HEALTH DEPARTMENT

STATESVILLE 704-878-5305 MOORESVILLE 704-664-5281

IMPROVEMENT PERMIT / AUTHORIZATION TO CONSTRUCT / OPERATION PERMIT / EXISTING SYSTEM INSPECTION

PERMIT# ~~12,0208~~/135574 PIN# 4746-70-3240 3182 DATE 12-8-06

OWNER OR APPLICANT JEHOVAH'S WITNESSES PHONE: Business c/o 704-902-1294 Home

ADDRESS 730 STONECREST DRIVE, STATESVILLE NC 28625

LOCATION US 21 NORTH, TR JANE SOWERS ROAD, TR JAMES FARM ROAD, TRACT ON LEFT

SUBDIVISION BLOCK / SECTION LOT LOT AREA SITE CLASS. PS' DESIGN FLOW 594 L.T.A.R. 0.30 GPD/FT²

Septic Tank: 1500 Gallons; STB 1011 Date 5-15-07

Pump Tank: Gallons; PT Date

Pump Make: Model Serial No.

Nitrification Field: No Fields 1 Square Feet EQ TO 2000 Linear Feet 500

No Lines FIVE Trench Width 36" Max Trench Bottom Depth 28"

☑ New System ☐ Repair ☐ Expansion System Type: I II III IV V VI

System Description: 25% REDUCTION, GRAVITY

Repair System Description: 25% REDUCTION, GRAVITY

Maintenance Agreement Required: ☐ Yes ☑ No

Gravel Depth N/A ☑ Gravity ☐ Pressure

☐ House/Mod. Home ☐ Mobile Home ☐ Business ☑ Other CHURCH @ 198 SEATS

No. Bedrooms No. Persons No. Employees


Water Supply: ☐ Individual ☐ Public ☐ Community

☐ Slab ☐ Crawl Space ☐ Basement w/plumbing ☐ Basement wo/plumbing

Comments:/Conditions: ① REMOVE EXISTING FIELD TERRACES.
② INSTALL 25% REDUCTION SYSTEM ON CONTOUR.
③ USE 1500 GALLON SEPTIC TANK WITH RISERS.

Comments:/Conditions:

INITIAL SITE SKETCH

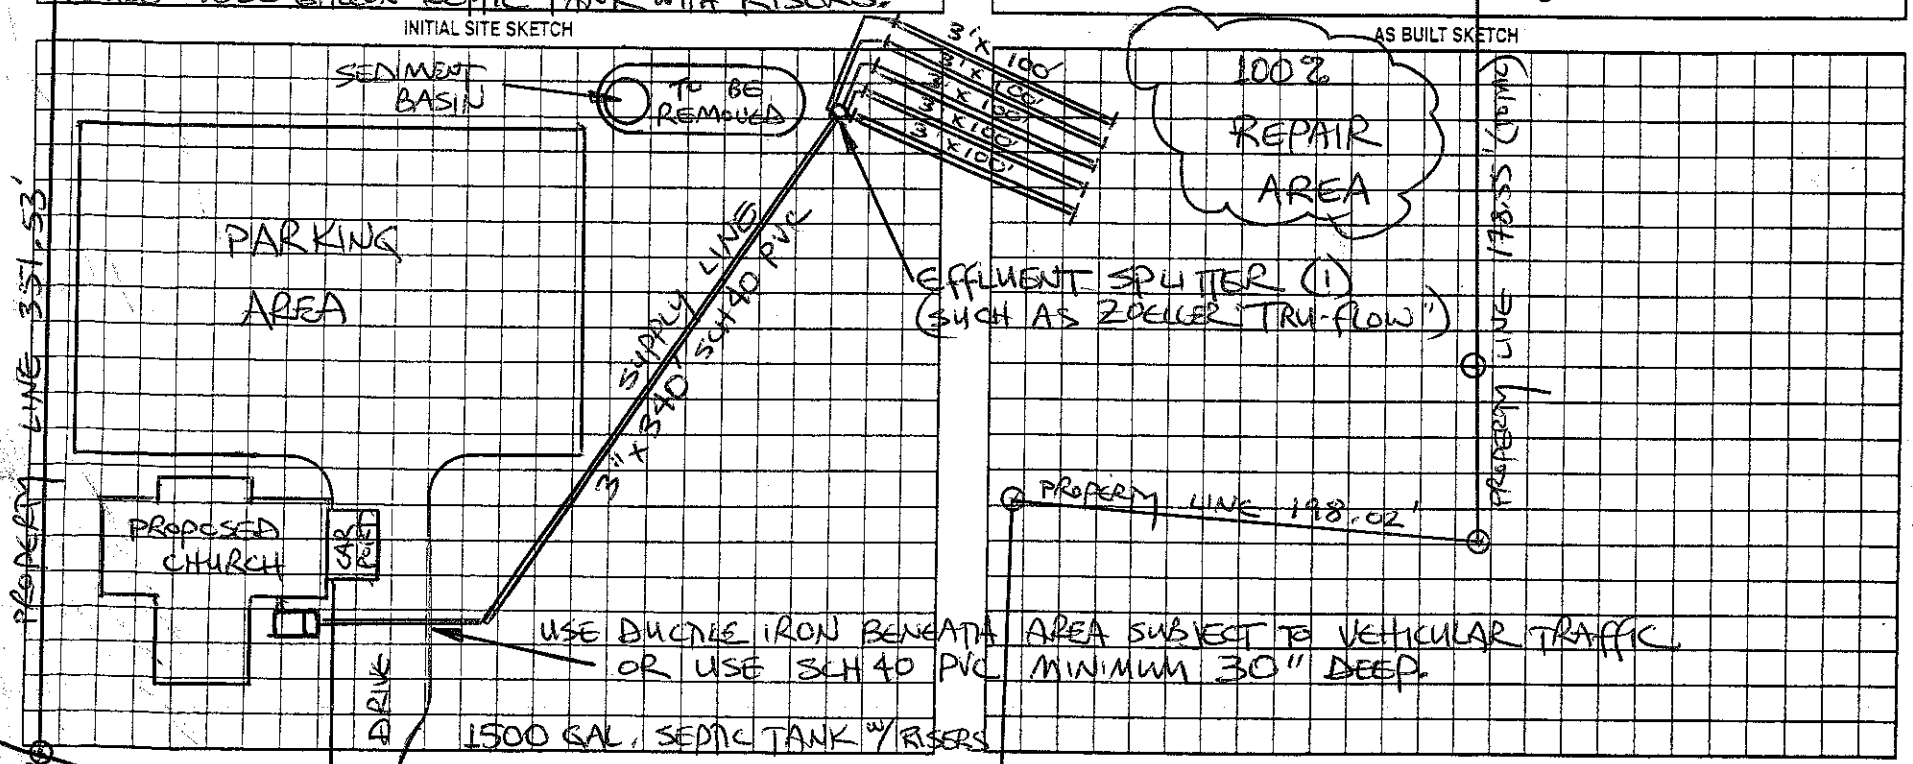

AS BUILT SKETCH

Permit can be suspended or revoked if any false information is supplied toward securing the permit/any unauthorized changes are made to the site/any unauthorized changes are made in the installation of the system. Improvement Permit with plat valid without expiration ☐ Improvement Permit with site plan valid for sixty months ☐ Authorization to Construct is valid for a period equal to that of Improvement Permit – not to exceed sixty months.

Signed: date 12/13/06 Installed by: STEVE JORDAN

Improvement Permit by: STEVE HEDRICK date 12-8-06 Operation Permit by: date 8-20-07

Authorization to Construct by: STEVE HEDRICK date 12-8-06 Existing System Inspection by: date

HEALTH DEPT. COPY: WHITE OWNER COPY (FINAL): YELLOW OWNER COPY (INITIAL): PINK