IREDELL COUNTY HEALTH DEPARTMENT

STATESVILLE 704-878-5305 MOORESVILLE 704-664-5281

IMPROVEMENT PERMIT / AUTHORIZATION TO CONSTRUCT / OPERATION PERMIT / EXISTING SYSTEM INSPECTION

PERMIT# 80633 PIN# 4746720641 DATE 4-22-99

OWNER OR CONTRACTOR William Mc Alpin PHONE: Business Home 876 4928

ADDRESS 614 Jennings Rd Statesville N.C.

LOCATION 21 N TR Fruit Truck To marion bn at end

SUBDIVISION Sherwood Forest BLOCK / SECTION LOT 14 LOT AREA 1.41 acres SITE CLASS PS DESIGN FLOW 360 L.T.A.R. .133

Septic Tank: 1000 Gallons; STB 1012 Date 8-29-99
Pump Tank: Gallons; PT Date
Pump Make: Model Serial No.
Nitrification Field: No Fields 1 Square Feet 810 Linear Feet 270
No Lines 4 Trench Width 36" Max Trench Bottom Depth 36" Gravel Depth N/A

☑ New System ☐ Repair System Type: I. II. III. IV. V. VI
System Description: Gravity 270 Rock
Repair System Description: Parallel Gravity
Maintenance Agreement Required: ☐ Yes ☑ No


☑ House/Mod. Home No. Bedrooms 3
☐ Mobile Home No. Bathrooms 3
☐ Business No. Employees
☐ Other
☐ Slab ☐ Crawl Space ☐ Basement w/plumbing ☐ Basement wo/plumbing

Water Supply: ☐ Individual ☑ Public ☐ Community

Comments/Conditions:

Comments /Conditions:

INITIAL SITE SKETCH

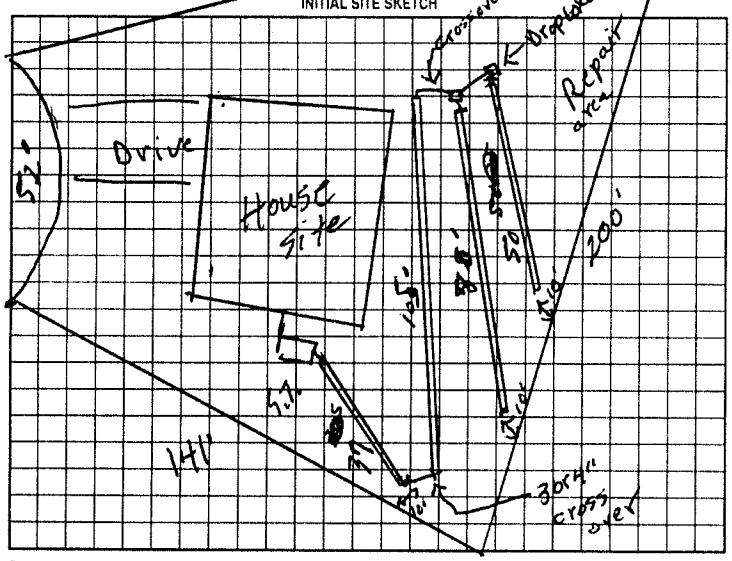

AS BUILT SKETCH

Same as initial Sketch

Permit can be suspended or revoked if any false information is supplied toward securing the permit/any unauthorized changes are made to the site/any unauthorized changes are made in the installation of the system. Improvement Permit with plat valid without expiration. Improvement Permit with site plan valid for sixty months. Authorization to Construct is valid for a period equal to that of Improvement Permit – not to exceed sixty months.

Signed: William F. McAlpin date 4-23-99 Installed by: David Yountz

Improvement Permit by: P. C. Moore date 4-22-99 Operation Permit by: P. C. Moore date 10-29-99

Authorization to Construct by: P. C. Moore date 4-22-99 Existing System Inspection by: date

HEALTH DEPT. COPY WHITE OWNER COPY (FINAL) YELLOW OWNER COPY (INITIAL) PINK