IREDELL COUNTY HEALTH DEPARTMENT

STATESVILLE 704-878-5305 MOORESVILLE 704-664-5281

IMPROVEMENT PERMIT / AUTHORIZATION TO CONSTRUCT / OPERATION PERMIT / EXISTING SYSTEM INSPECTION

PERMIT# 151508 PIN# 4746723679 DATE 7-16-08

OWNER OR APPLICANT Allen Lewis PHONE: Business _____ Home 704-878-2305

ADDRESS 165 New Hope Rd Statesville NC 28625

LOCATION Jane Sowers RD @ James Lawn 3 lot on right

SUBDIVISION _____ BLOCK / SECTION _____ LOT _____ LOT AREA .96 SITE CLASS. 3 DESIGN FLOW 360 L.T.A.R. .23

Septic Tank: 1500 Gallons; STB 1012 Date 7-24-08

Pump Tank: _____ Gallons; PT _____ Date _____

Pump Make: _____ Model _____ Serial No. _____

Nitrification Field: No Fields ___ Square Feet 1440 Linear Feet 360

No Lines 5 Trench Width 36" Max Trench Bottom Depth 36" Gravel Depth _____

☑ New System ☐ Repair ☐ Expansion System Type: I II III IV V VI

System Description: 25% Graywater

Repair System Description: 30% Low Pressure

Maintenance Agreement Required: ☐ Yes ☐ No

☑ House/Mod. Home ☐ Mobile Home ☐ Business ☐ Other

No. Bedrooms 3 No. Persons ___ No. Employees ___

Water Supply: ☐ Individual ☑ Public ☐ Community

☐ Gravity ☐ Pressure ☐ Slab ☐ Crawl Space ☐ Basement w/plumbing ☐ Basement wo/plumbing


Comments:/Conditions:

2@ 90
1@ 80
2@ 50

Comments:/Conditions:

Install as contract
Maintain all setback

INITIAL SITE SKETCH

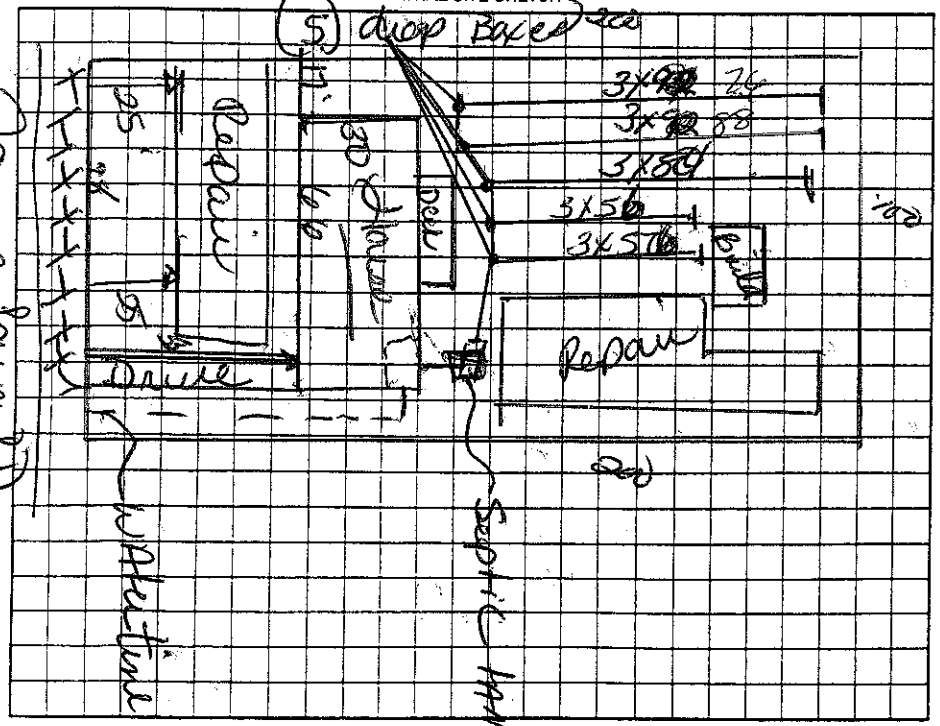

AS BUILT SKETCH

Permit can be suspended or revoked if any false information is supplied toward securing the permit/any unauthorized changes are made to the site/any unauthorized changes are made in the installation of the system. Improvement Permit with plat valid without expiration ☐ Improvement Permit with site plan valid for sixty months ☑ Authorization to Construct is valid for a period equal to that of Improvement Permit – not to exceed sixty months.

Signed: _____ date 7-16-08 Installed by: _____

Improvement Permit by: _____ date 7-16-08 Operation Permit by: _____ date 4-21-09

Authorization to Construct by: _____ date 7-16-08 Existing System Inspection by: _____ date _____

HEALTH DEPT. COPY: WHITE OWNER COPY (FINAL): YELLOW OWNER COPY (INITIAL): PINK