IREDELL COUNTY HEALTH DEPARTMENT

STATESVILLE 704-878-5305 MOORESVILLE 704-664-5281

IMPROVEMENT PERMIT / CERTIFICATE OF COMPLETION / OPERATION PERMIT / EXISTING SYSTEM INSPECTION

PROPERTY DESCRIPTION NO. 13463 DATE 9/9/93 TAX MAP NO. 10B- A-81

OWNER OR CONTRACTOR CLAUDE WAYNE ASHLEY PHONE: Business Home

ADDRESS

LOCATION US 21 N. TR JANE SOWERS RD, TR JAMES FARM RD, 4th House on R

SUBDIVISION BLOCK / SECTION LOT LOT AREA SITE CLASS. PS L.T.A.R. EXISTING

Water Supply: ☐ Individual ☐ Community ☑ Public

Septic Tank: 1500 Gallons; STB Date

Pump Tank: Gallons; PT Date

Nitrification Field: No. Fields Square Feet 300 Linear Feet 100

No. Lines 4 (1) Trench Width 36" Trench Depth Gravel Depth 12"

☐ New System ☑ Repair System Type: (I.) II. III. IV. V. VI

System Description: CONV. GRAVITY

Repair System Description: CONV. GRAVITY

Maintenance Agreement Required: ☐ Yes ☑ No

☑ House/Mod. Home No. Bedrooms 3 Garbage Disposal: ☑ Yes ☐ No

☐ Mobile Home No. Bathrooms 2 Auto. Dishwasher: ☑ Yes ☐ No

☐ Business No. Employees Auto. Washing Machine: ☑ Yes ☐ No


☐ Other Other

☐ Slab ☑ Crawl Space ☐ Basement w/plumbing ☐ Basement wo/plumbing

Comments (1) RESET OLD 1500 GAL S.T. AT LOCATION SHOWN.
(2) OLD LINES BLOCKED OFF 5' FROM ADDITION FOUNDATION
(3) NEW D. BOX INSTALLED AS SHOWN.
(4) NEW 3'x100' LINE INSTALLED AS SHOWN.

INITIAL SITE SKETCH

AS-BUILT SKETCH

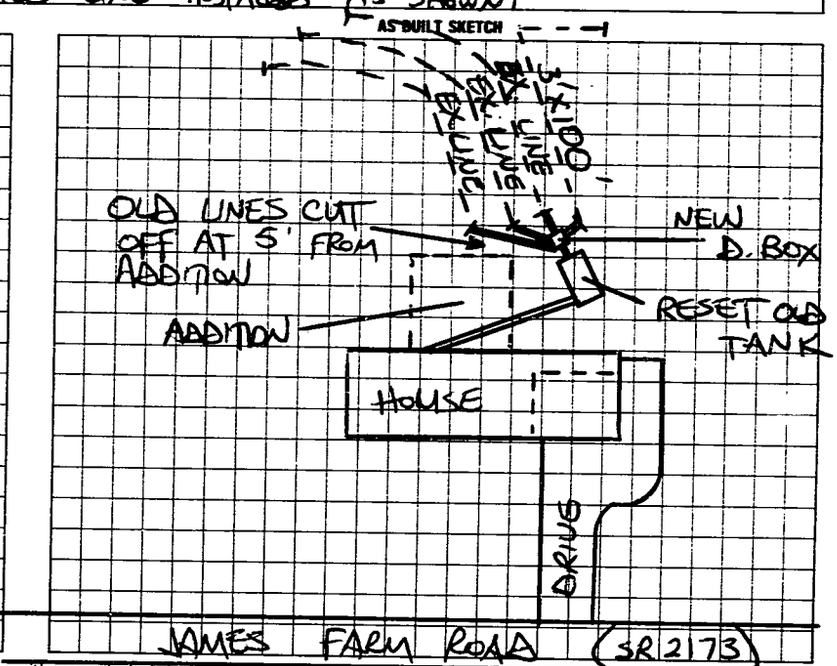

I understand that this permit can be suspended or revoked if any false information is supplied toward securing the permit/any unauthorized changes are made to the site/any unauthorized changes are made in the installation of the system. Improvement Permit is valid for 60 months from date of issuance.

Signed:

Improvement Permit by: J.C. MOORE date 9/25/91

Existing System Inspection by: date

Installed by: HARRY REED

Certificate of Completion by: STEVE HENDRICK date 9/9/93

Operation Permit by: date

HEALTH DEPT. COPY: WHITE INSPECTION COPY (FINAL): GREEN OWNER COPY (FINAL): YELLOW INSPECTION COPY (INITIAL): PINK OWNER COPY (INITIAL): GOLD