IREDELL COUNTY HEALTH DEPARTMENT

Statesville Phone TR 3-7271 Mooresville Phone NO 3-1271

PERMIT TO INSTALL SEPTIC TANK

Permit NO. _____ Permit Date 11 1962

Owner Mrs. M. G. Tuckey Address _____

Installed By Roy Grant Address Statesville

Location of Property Idlewood Forest Trail


Brick House on Left

Tank	Capacity	Length of Lines	Fixtures
Block ( )	800 ( )	150' ( )	No. of Baths (1)
Precast ( )	900 ( )	175' ( )	Dishwasher ( )
Pond	1000 (✓)	200' ( )	Garbage Grdr. ( )
	1100 ( )	225' (✓)	Auto-Washer (✓)
	1200 ( )	250' ( )	Other _____
	Other _____	Other _____	

NOTIFY HEALTH DEPARTMENT AT LEAST EIGHT HOURS BEFORE TANK IS TO BE INSPECTED.

Final Inspection 11 1962 Approved (✓) Disapproved ( )

Remarks Overall

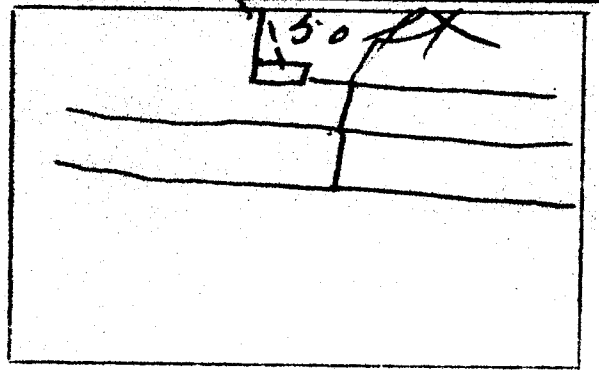

Sketch of Installation

Sanitarian