IREDELL COUNTY HEALTH DEPARTMENT

Statesville Phone TR 3-7271 — Mooresville Phone NO 3-1271

PERMIT TO INSTALL SEPTIC TANK

Permit NO. Paul Gibson owner — Permit Date Jan 23 1963

Owner J.C. Gant Elder — Address Sherwood Forest

Installed By C Hoke — Address R7


Location of Property last on left on main Rd. in Subdivision - Sherwood Forest

Tank		Capacity		Length of Lines		Fixtures	
Block	( )	800	( )	150'	( )	No. of Baths	(2)
Precast	(1)	900	( )	175'	( )	Dishwasher	( )
		1000	(1)	200'	( )	Garbage Grdr.	( )
		1100	( )	225'	(1)	Auto-Washer	(1)
		1200	( )	250'	( )	Other	
		Other		Other			

NOTIFY HEALTH DEPARTMENT AT LEAST EIGHT HOURS BEFORE TANK IS TO BE INSPECTED.

Final Inspection 1-23 1963 — Approved (1) Disapproved ( )

Remarks Very deep - due to stool in basement.

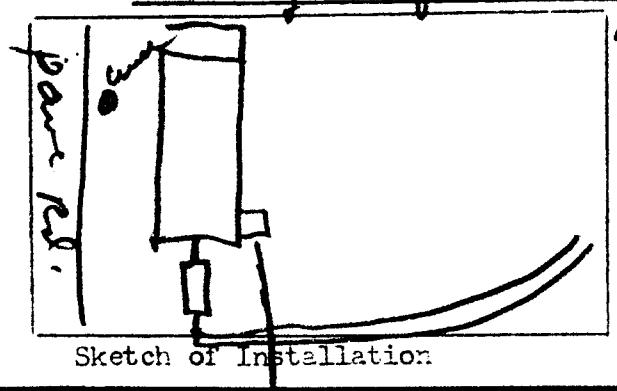

Sketch of Installation

average fill over lines 36" - width 65'
Basement drain cast iron goes over drain.

Rut

Sanitarian