# IREDELL COUNTY HEALTH DEPARTMENT

STATESVILLE 704-878-5305 MOORESVILLE 704-664-5281 (c1)

## IMPROVEMENT PERMIT / AUTHORIZATION TO CONSTRUCT / OPERATION PERMIT / EXISTING SYSTEM INSPECTION

PERMIT# 136403 PIN# 4774673217 DATE 6-28-06

OWNER OR APPLICANT Ronnie Dorsett PHONE: Business 364-662-0731 Home

ADDRESS 113 Sipsey Cove Ln Mooresville NC 28117

LOCATION 21W TO JAVE Sewis at Lake James Town

SUBDIVISION Sherwood Forest BLOCK / SECTION LOT 5 LOT AREA 1.7 SITE CLASS PS DESIGN FLOW 360 L.T.A.R. .2

Septic Tank: 1000 Gallons: STB 1012 Date 4-29-06
Pump Tank: Gallons; PT Date
Pump Make: Model Serial No.
Nitrification Field: No Fields 1 Square Feet 600 Linear Feet 360
No Lines 3 PWO Trench Width 36" Max Trench Bottom Depth 24"-30"-36" Gravel Depth NA

☐ New System ☐ Repair ☐ Expansion System Type: I II III IV V VI
System Description: 25% Graub
Repair System Description: 25% Repair
Maintenance Agreement Required: ☐ Yes ☐ No


☑ House/Mod. Home No. Bedrooms 3
☐ Mobile Home No. Persons
☐ Business No. Employees
☐ Other

Water Supply: ☐ Individual ☑ Public ☐ Community

☐ Gravity ☐ Pressure ☐ Slab ☑ Crawl Space ☐ Basement w/plumbing ☐ Basement wo/plumbing


Comments/Conditions:
Install on Contour
Maintain all Setbacks

INITIAL SUE SKETCH

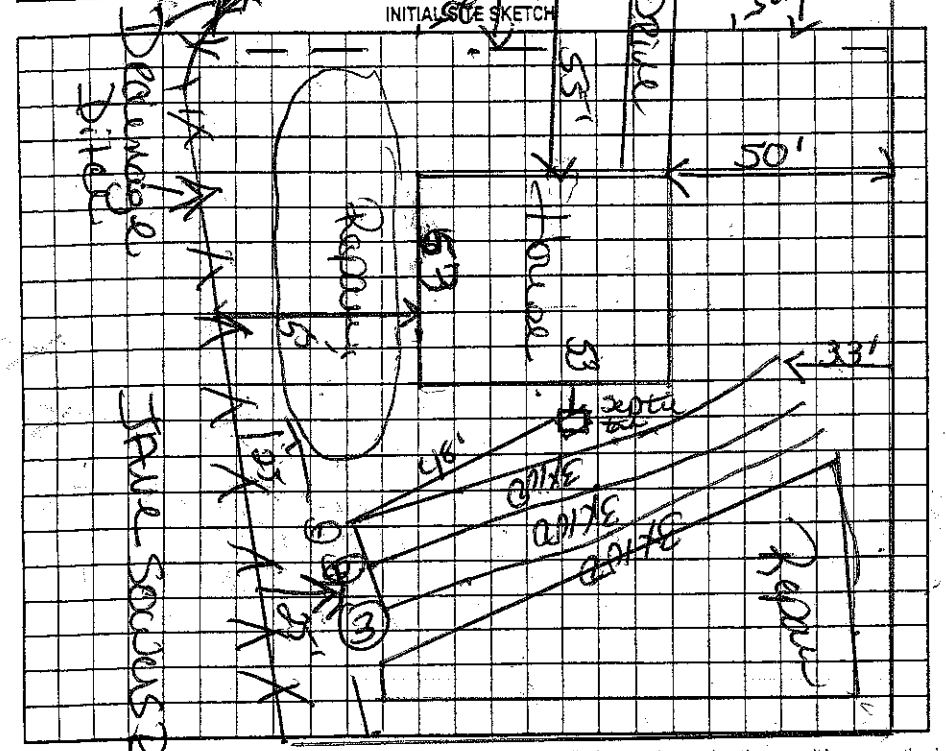


Comments/Conditions:
① - 24" Deep
② 30" Depth
③ 36" Depth
④ Use Chamber as serial distributer -
⑤ Shallow tank
SYSTEM ALTERED TO TWO 3'x150' LINES IN ORDER TO MAINTAIN MAX TRENCH DEPTH

AS-BUILT SKETCH

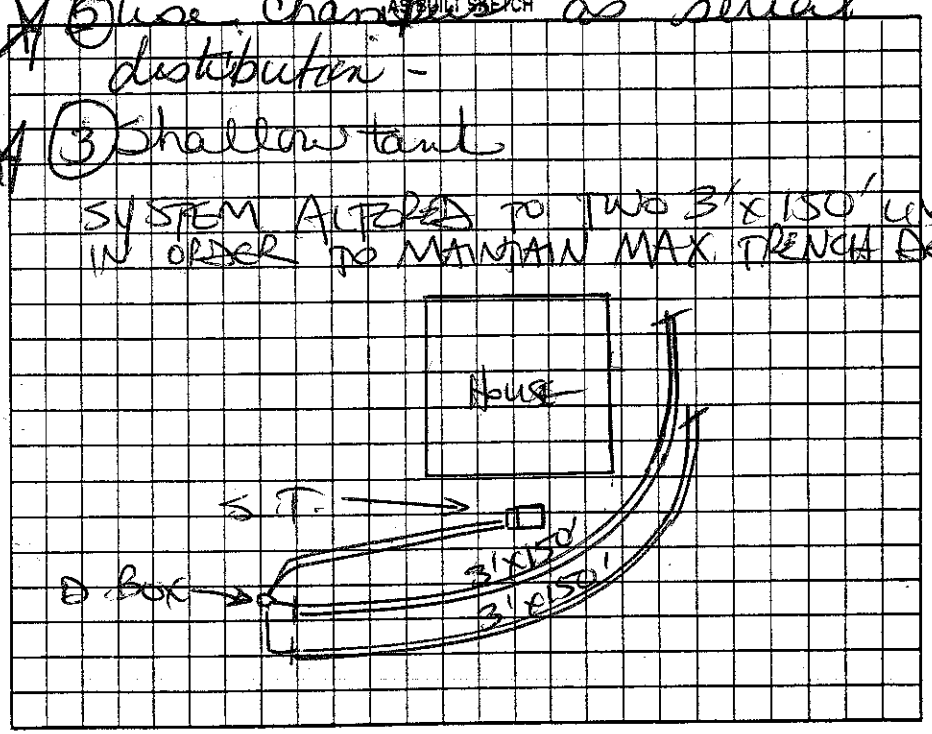


Permit can be suspended or revoked if any false information is supplied toward securing the permit/any unauthorized changes are made to the site/any unauthorized changes are made in the installation of the system. Improvement Permit with plat valid without expiration ☐ Improvement Permit with site plan valid for sixty months ☐ Authorization to Construct is valid for a period equal to that of Improvement Permit – not to exceed sixty months.

Signed: date
Improvement Permit by: date 6-28-06
Authorization to Construct by: date 6-28-06
Installed by: CRAIG THOMPSON
Operation Permit by: STEVE HENDRICK date 12-11-06
Existing System Inspection by: date

HEALTH DEPT. COPY: WHITE OWNER COPY (FINAL): YELLOW OWNER COPY (INITIAL): PINK