IREDELL COUNTY HEALTH DEPARTMENT

Statesville Phone TR 3-7271 Mooresville Phone NO 3-1271

PERMIT TO INSTALL SEPTIC TANK

Permit No. 71 Permit Date 3-10 1970

Owner Harry Laye Address Statesville, NC.

Installed By Lloyd Adams Address Taylorsville NC.


Location of Property Hwy 21 N. 11th house on Rt before Evans Rd.

Tank		Capacity		Length of Lines		Fixtures	
Block	( )	1000	( )	225'	( )	No. of Baths	( )
Precast	( )	1250	( )	250'	( )	Dishwasher	( )
		1500	( )	Other		Garbage Grdr.	( )
		Other				Other	

NOTIFY HEALTH DEPARTMENT AT LEAST EIGHT HOURS BEFORE TANK IS TO BE INSPECTED.

Final Inspection 3-10 1970 Approved ( ) Disapproved ( )

Remarks Connected To Iredell Water Co. System.

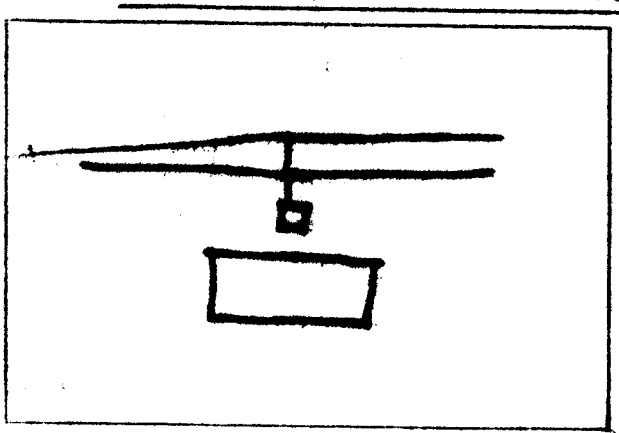

Sketch of Installation

Andrew F. Hutchins R.S.

Sanitarian