IREDELL COUNTY HEALTH DEPARTMENT

Statesville Phone TR 3-7271 Mooresville Phone NC 3-1271

PERMIT TO INSTALL SEPTIC TANK

Permit NO. Bethany Permit Date July 25 1957

Owner Home Demonstration Club Address Rte 21

Installed By E. Yoke Address Route 7, City

Location of Property Across from Rose Chapel Ch. on 21


| Tank | | Capacity | | Length of Lines | | Fixtures | |
|---|---|---|---|---|---|---|---|
| Block | ( ) | 800 | (✓) | 150' | (✓) | No. of Baths | ( ) |
| Precast | (✓) | 900 | ( ) | 175' | ( ) | Dishwasher | ( ) |
| | | 1000 | ( ) | 200' | ( ) | Garbage Grdr. | ( ) |
| | | 1100 | ( ) | 225' | ( ) | Auto-Washer | ( ) |
| | | 1200 | ( ) | 250' | ( ) | Other | |
| | | Other | | Other | | | |

NOTIFY HEALTH DEPARTMENT AT LEAST EIGHT HOURS BEFORE TANK IS TO BE INSPECTED.


Final Inspection 195 Approved ( ) Disapproved ( )

Remarks Self Disp - Not for washer

Refund C. H.

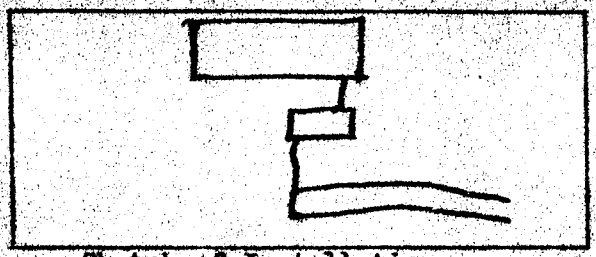

Sketch of Installation

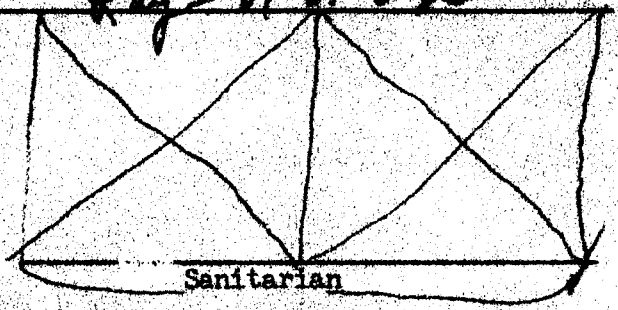

Sanitarian