ICHD - ENVIRONMENTAL HEALTH DIVISION

Statesville Office (704) 878-5305 Mooresville Office (704) 660-3625 PERMIT # AP 329308

SEPTIC: IMPROVEMENT PERMIT / AUTHORIZATION TO CONSTRUCT / OPERATION PERMIT / EXISTING SYSTEM

PIN # 4746 -- 93 -- 1989

APPLICANT/OWNER: Johnny Martin APPLICANT ADDRESS: 311 Jane Sowers Rd Statesville 28125

SITE ADDRESS: 311 Jane Sowers Rd Statesville 28625 PHONE: 704-576-0502 ALT. PHONE

SITE DIRECTIONS: 21 N. (R) on Jane Sowers Rd. First brick on Left SAP CONTROLLED: ☐ YES ☐ NO

SUBDIVISION: — SECTION: — LOT # — LOT AREA: — DESIGN FLOW: Ext L.T.A.R.: Ext


Septic Tank	1000	(gal)	STB	760	Date	4-18-22	☐ New System	☑ Repair	☐ Expansion	System Type: I II (III) IV V VI	
Pump Tank		(gal)	PT		Date		System Description:	Tank Replacement			
Pump Make			Model		Serial #		Repair System Description:	Ext			
# Nitrification Fields	Ext	# Lines	Ext		Linear Ft	Ext	Maintenance Agreement Required:	☐ YES	☑ NO		
Trench Width	Ext	Trench Bottom Depth(Low side)		Ext	Gravel Depth	Ext	☑ GRAVITY	☐ PRESSURE			

☐ Residence No. Bedrooms 3 ☐ Business No. Persons 2 ☐ Other No. Employees ☐ Slab ☐ Crawl Space ☐ Basement w/plumbing ☑ Basement w/o plumbing

Water Supply ☐ Private ☐ Public ☐ Community

Comments / Conditions: Pump, crush, fill old tank. Tank is located behind house with washer hooked up. All other plumbing goes to other system on the left side of the house.

INITIAL SITE SKETCH

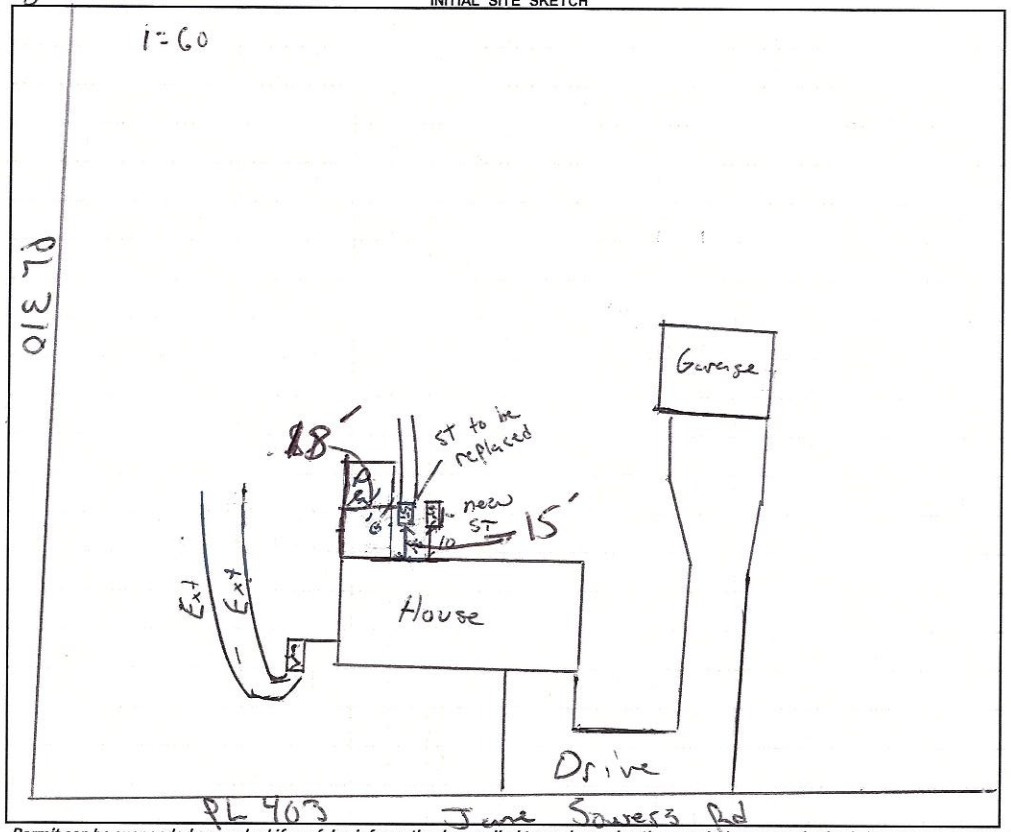

AS BUILT SKETCH

Installed as drawn

FOR SEPTIC FINAL INSPECTION CALL: 704-664-3703 between 8am-9am
the day the inspection is needed. Be sure to speak with an inspector to confirm your time.

Permit can be suspended or revoked if any false information is supplied toward securing the permit / any unauthorized changes are made to the site / any unauthorized changes are made in the installation of the system. **CONTACT A LOCATOR SERVICE PRIOR TO ANY EXCAVATION**

☐ **IMPROVEMENT PERMIT** *with plat valid without expiration.* ☑ **IMPROVEMENT PERMIT** *with site plan valid for 60 mos.* ☐ **AUTHORIZATION TO CONSTRUCT** *valid for period equal to IMPROVEMENT PERMIT--not to exceed 60 mo.*

Owner / Applicant Signature: Johnny P. Martin Date: 6-10-22 Installed by: Lantz Wastewater

IMPROVEMENT PERMIT by: [signature] Date: 6/9/22 OPERATION PERMIT by: [signature] Date: 6/20/22

AUTHORIZATION TO CONSTRUCT by: [signature] Date: 6/9/22 Existing System Inspected by: Date:

FOR SEPTIC FINAL INSPECTION: CALL 704-664-3703 between 8am-9am the day the inspection is needed.

RECEIVED JUN 0 1 2022

APPLICATION MUST BE FILLED OUT COMPLETELY & BE LEGIBLE OR IT WILL NOT BE PROCESSED

Iredell County Health Department – Environmental Health Division

PAGE 1: *APPLICATION FORM* AP-329308

Repair Final

Application For: ( ) New Well Permit ( ) Well Repair Permit ( ) Well Abandonment
( ) Septic Improvement Permit ( ) Authorization to Construct ( ) Existing System Inspection (✓) Septic System Repair

THE ABOVE PERMIT DOCUMENTS WILL BECOME INVALID IF INFORMATION PROVIDED ON THIS APPLICATION IS FALSIFIED OR CHANGED, OR IF THE SITE IS ALTERED. THE IMPROVEMENT PERMIT IS VALID FOR EITHER 60 MONTHS OR WITHOUT EXPIRATION DEPENDING UPON DOCUMENTATION SUBMITTED. APPLICATION WITH SITE PLAN 60 MONTHS, APPLICATION WITH COMPLETE, SCALED PLAT WITHOUT EXPIRATION. SEE 15A NCAC 18A .1937(f) FOR DETAILS.

Page 2: *Site Plan Worksheet* form MUST accompany this application

The following optional attachments may also be submitted: ( ) Survey Plat, scaled no more than 1 inch = 60 feet
Place an (X) beside whichever is submitted if applicable ( ) Custom Site Plan, scaled no more than 1 inch = 60 feet

Applicant Information: (PRINT CLEARLY)

Applicant Name: Johnny P. Martin Address: 311 Jane Sowers Rd, Statesville N.C. Zip: 28625
Applicant Email: N/A Phone: 704-876-0802 Alt. Phone: _____
Owner Name: Johnny P. Martin Address: 311 Jane Sowers Rd, Statesville, N.C. Zip: 28625
Owner Email: N/A Phone: 704-876-0802 Alt. Phone: _____

Property Information:

Street Address: 311 Jane Sowers Rd, Statesville, N.C. 28625
Subdivision Name: _____ Section/Phase: _____ Lot Number: _____
Driving Directions: ~~Hwy~~ 21 North, ~~Left~~ Right on Jane Sowers Rd, First brick on Left. After you Cross Interstate 77

Site Development Information: *(check or complete ALL that apply*

CHECK FOUNDATION TYPE

( ) New Single Family Residence Maximum Number of Bedrooms: 3 ( ) Crawl Space Foundation
( ) New Multi-Family Residence Maximum Number of Occupants: 1 (✓) Concrete Slab Foundation
( ) Accessory Building ( ) Swimming Pool ( ) Basement with Plumbing
( ) Bedroom(s) Addition ( ) Other Addition/Structure: _____ ( ) Basement without Plumbing
(✓) Repair to failing septic system ✓ Tank ___ Drain lines Describe Problem: Top Fell In
Non-Residential Site Development: Type of Business: _____
Square Footage of Building: _____ Max. Number of Employees: _____ Max. Number of Seats/Beds/Other: _____

Water Supply: ( ) Replacement Well – Reason: _____
( ) Multi-connection Well Number of Houses: _____ Number of Persons: _____
( ) New Well ( ) Existing Well ( ) Community Well ( ) City Water ( ) Other Public Water

Desired Septic System Type: *(you may rank in order of preference)* Year existing system installed: 1968
( ) No Preference ( ) Alternative ( ) Conventional ( ) Innovative ( ) Modified Conventional ( ) Other: _____

Please answer the following to the best of your ability:
( ) Yes (✓) No Does the site contain any jurisdictional wetlands?
( ) Yes (✓) No Is any non-domestic sewage (i.e. industrial) to be generated?
( ) Yes (✓) No Is the site subject to approval by any other public agency?

I have read this application and certify that the information provided herein is true, complete, and correct. Authorized county and state officials are granted right of entry to conduct necessary inspections to determine compliance with applicable laws and rules. I understand that I am solely responsible for the proper identification and labeling of all property lines and corners and making the site accessible so that a complete site evaluation can be performed.

Signature: Johnny P Martin 6-1-2022
Property owner or owner's legal representative signature (SIGNATURE REQUIRED) DATE

IREDELL COUNTY DEPARTMENT OF ENVIRONMENTAL HEALTH

DOCUMENTATION TO AUTHORIZE AN OWNER'S LEGAL REPRESENTATIVE

(Check and sign only ONE of the options below)

☐ 1. * APPLICANT AND OWNER ARE THE SAME. * (*Sign here*) Johnny P. Martin

Applications for permits require the "signature of the owner or owner's legal representative" (15A NCAC 18A .1937). If the owner does not sign the application himself or herself, they can submit any one of the following documents to designate their legal representative: *Power of Attorney; Real Estate Contract; Estate executor; Bankruptcy trustee; Court ordered guardianship* In the absence of the above documentation, the property owner may provide the local health department with documentation that designates a legal representative. A property owner may:
Complete this form to document his or her legal representative, or provide his or her own form that contains the information in this form. If there are multiple property owners, then all property owners must sign the form that designates a legal representative.
By signing a form that designates a legal representative for purposes of 15A NCAC 18A .1937, the property owner authorizes that representative to act on their behalf in matters pertaining to the application and permitting process, including signing or receiving any application, document or permit. The owner retains full responsibility to meet all permit conditions specified by the local health department.

☐ 2. I, Johnny P. Martin, am the legal owner(s) of the property located at 311 Jane Sowers Rd, Statesville, N.C. 28625 identified as PIN (Parcel Identification Number)_____, located in Iredell County, North Carolina.

I do hereby authorize (**print legal representative/company name**) _____, _____, to act as an agent on my behalf in applying for/signing/obtaining any of the documents described below.

- Application for Improvement Permit (IP) / Authorization to Construct (AC)
- Improvement Permit (IP) / Authorization to Construct (AC)
- Application for soil-site evaluation (new/repair)
- Application/permit for private drinking water well/well abandonment
- Application for Compliance Inspection

I agree to abide by all decisions and/or conditions between the legal representative acting on my behalf and the Iredell County Department of Public Health, Environmental Health Division.

Johnny P. Martin
Signature of Owner(s)

10-1-2025
Date

Mooresville - Environmental Health
Fax: 704-662-3239
610 E. Center Avenue, Mooresville, NC 28115


Statesville - Environmental Health
ronda.hart@co.iredell.nc.us
Fax: 704-871-3483
349 N. Center Street, Statesville, NC 28677

IREDELL COUNTY HEALTH DEPARTMENT

ENVIRONMENTAL HEALTH DIVISION

PAGE 2: *SITE PLAN WORKSHEET*

SEE THE "SAMPLE SITE PLAN" BELOW. *INCOMPLETE SITE PLANS WILL BE RETURNED TO YOU FOR COMPLETION AND MAY RESULT IN A DELAY IN THE ISSUANCE OF YOUR SEPTIC SYSTEM PERMIT!!!*

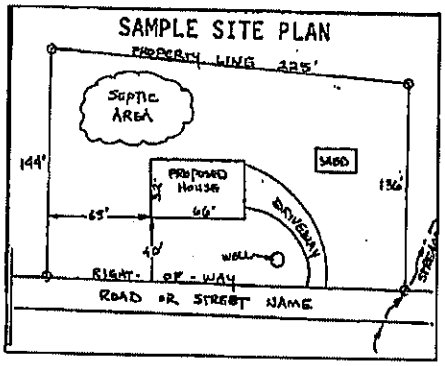

Place an (X) beside each item as you complete the site plan:


( ) Property Line measurements are clearly identified
( ) All proposed structures are indicated
( ) Front and side setbacks from property line
( ) Preferred driveway location and well location
( ) Area you prefer your septic system to be placed
( ) North arrow, or other sufficient indicator of direction

Circle N/A on the following if appropriate:

Location of septic systems and wells within 100' of your property	N/A
Location of easements and rights of ways on your property	N/A
Location of any designated wetlands on the property	N/A

USE THIS SPACE TO DRAW YOUR SITE PLAN

Show: proposed house or business footprint, wells, water lines, patios, pools and decks, and any other item that will occupy space on the site

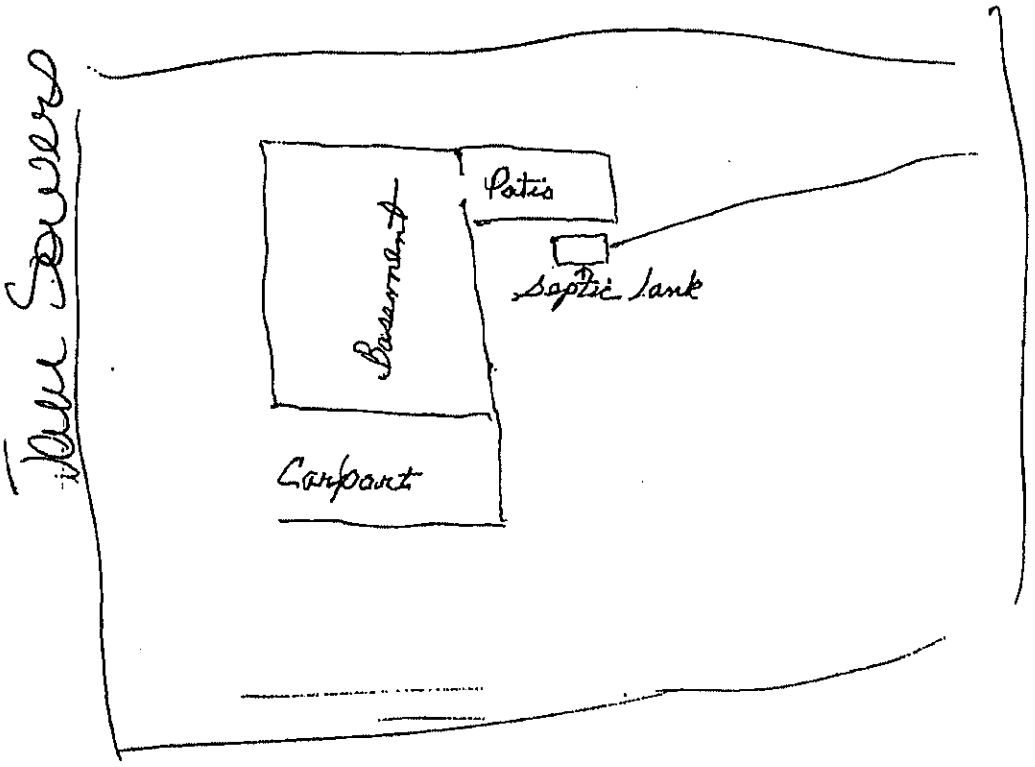

Signature: Johnny P. Martin
Property owner or owner's legal representative signature (SIGNATURE REQUIRED)

6-1-2022
DATE

IREDELL COUNTY HEALTH DEPARTMENT

(SEPTIC TANK) IMPROVEMENTS PERMIT AND CERTIFICATE OF COMPLETION
(Ground Absorption Sewage Disposal System – G. S. Chapter 130-Article 13C)

OWNER OR CONTRACTOR Johnny martin DATE 6-26-79 PERMIT NO. _____

PHONE: Business _____ Home _____


LOCATION 21 N TR on 2171 Jane Sowers Rd 1st brick house on left Past - I-77 S. R. No. _____

SUBDIVISION NAME _____ LOT NO. _____ SECTION OR BLOCK NO. _____

House ( ) Mobile Home ( ) Business ( ) Other _____

No. Bedrooms _____ No. Bathrooms _____
Garbage Disposal Unit Yes ( ) No ( )
Auto. Dishwasher Yes ( ) No ( )
Auto. Wash. Machine Yes ( ) No ( )
Site Suitable Yes ( ) No ( )
Lot Area _____

Character & Porosity of Soil _____
Percolation Rate _____
Topography Repair
Depth to Water Table _____
Rock or other impervious formations _____

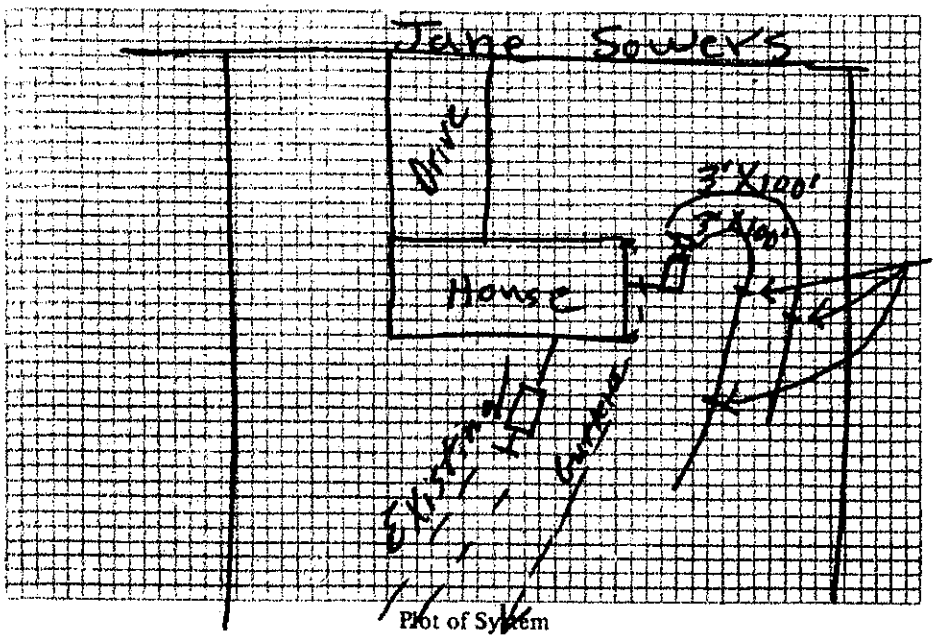

Size of Tank 1000 Gals.
Nitrification Field:
No. of Lines 2
Sq. Ft. 600 Linear Ft. 200
Depth of Stone in Lines 10"
Water Supply: Individual ( )
Public (✓)

Installed by Wayne Orbison

IMPROVEMENTS PERMIT BY R. C. moore 6-25-79 Replaces Permit issued 7-26-79

COMMENTS: upper system added to take care of all plumbing except washer which will use existing system * very important to pipe gutters away from Tank + lines

CERTIFICATE OF COMPLETION BY _____ DATE _____

CONSTRUCTION MUST COMPLY WITH ALL OTHER APPLICABLE STATE AND LOCAL REGULATIONS.

Health Dept. Copy: White Inspection Dept. Copy: Yellow Sanitarian's Copy: Pink Owner's Copy: Gold