IREDELL COUNTY HEALTH DEPARTMENT

Statesville Office (704) 878-5305 Mooresville Office (704) 660-3625 PERMIT # 204011

IMPROVEMENT PERMIT / AUTHORIZATION TO CONSTRUCT / OPERATION PERMIT / EXISTING SYSTEM

PIN # 4746937665

APPLICANT: Ricky Darnell APPLICANT ADDRESS: 140 Best Street Statesville NC

SITE ADDRESS: 326 Jane Sowers Rd Statesville NC PHONE: 704-437-3374 ALT. PHONE: 812-677-1935

SITE DIRECTIONS: Hwy 21 N T/L on Jane Sowers Rd Lot on right

SUBDIVISION: N/A SECTION: N/A LOT # N/A LOT AREA: 3.6ac DESIGN FLOW: 360 L.T.A.R.: EX

Septic Tank EX (gal) STB Date

Pump Tank (gal) PT Date

Pump Make Model Serial #

Nitrification Fields EX # Lines EX Linear Ft: EX

Trench Width EX Max. Trench Bottom Depth EX Gravel Depth EX

☐ New System ☐ Repair ☐ Expansion System Type: I (II) III IV V VI

System Description: Existing

Repair System Description:

Maintenance Agreement Required: ☐ YES ☒ NO ☒ GRAVITY ☐ PRESSURE

☒ Residence No. Bedrooms 3

☐ Business No. Persons 6

☐ Other No. Employees


☐ Slab ☒ Crawl Space

☐ Basement w/plumbing ☐ Basement w/o plumbing


Water Supply: ☒ Private ☒ Public ☐ Community

Comments / Conditions: All building foundations must be 35' from any part of SIS and 5.25' from any well. Addition can not increase in # of bedrooms for total house

INITIAL SITE SKETCH

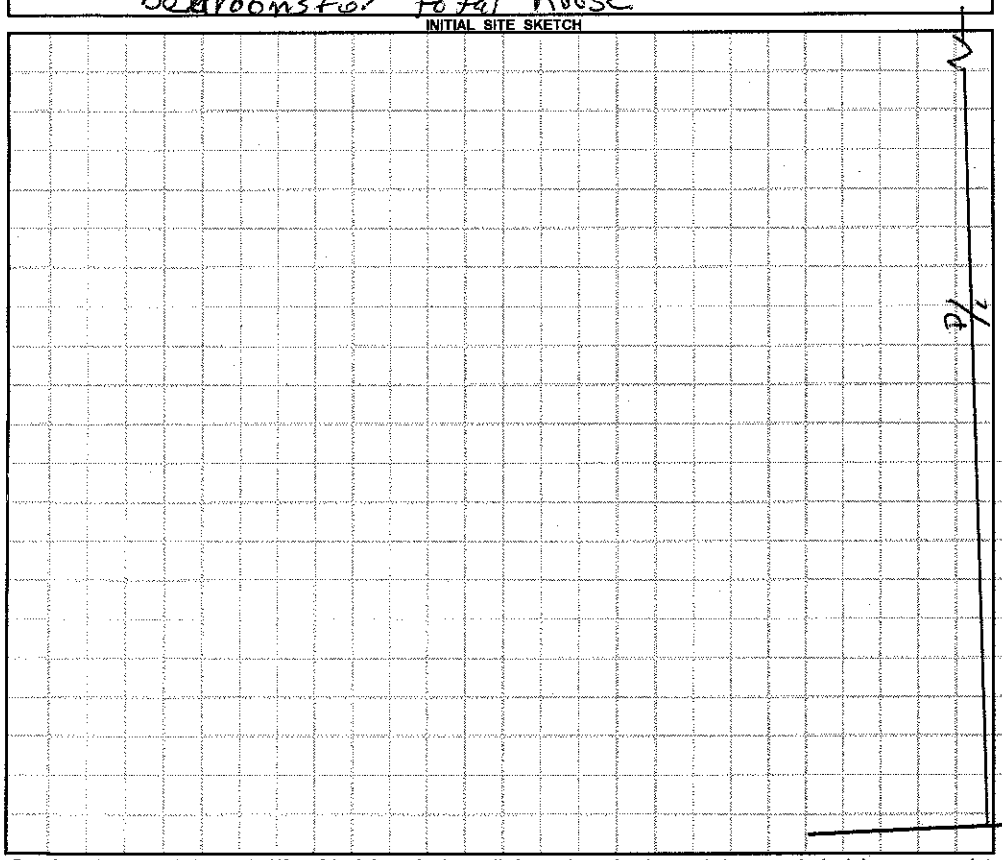

AS BUILT SKETCH

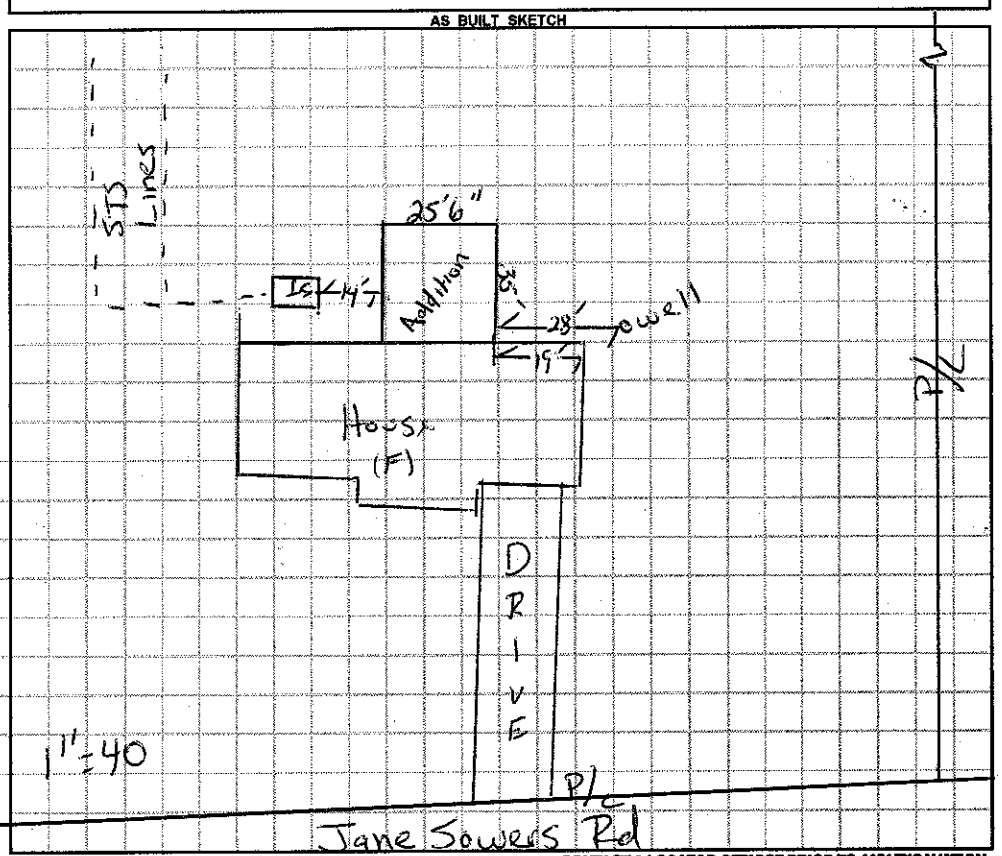

Permit can be suspended or revoked if any false information is supplied toward securing the permit / any unauthorized changes are made to the site / any unauthorized changes are made in the installation of the system. **CONTACT A LOCATOR SERVICE PRIOR TO ANY EXCAVATION**

☐ **IMPROVEMENT PERMIT** *with plat valid without expiration.* ☐ **IMPROVEMENT PERMIT** *with site plan valid for 60 mos.* ☐ **AUTHORIZATION TO CONSTRUCT** *valid for period equal to IMPROVEMENT PERMIT--not to exceed 60 mo.*

Owner / Applicant Signature: Ricky Darnell Date: 6/24/14 Installed by:

IMPROVEMENT PERMIT by: Date: OPERATION PERMIT by: Date:

AUTHORIZATION TO CONSTRUCT by: Date: Existing System Inspected by: Date: 06/17/14

Health Dept. Copy - WHITE Applicant (Final Approval) - YELLOW Applicant (Conditional Approval) - PINK