IREDELL COUNTY HEALTH DEPARTMENT

Statesville Phone TR 3-7271 Mooresville Phone NO 3-1271

PERMIT TO INSTALL SEPTIC TANK

Permit NO. _____ J.V. Thomason Biller Permit Date July 26 1963

Owner O.A. Jordon Address Sherwood Forest RD,

Installed By C Hoke Address R7


Location of Property R off 21 N at Esso Sta. Cross I-77 new Brick on R.

Tank		Capacity		Length of Lines		Fixtures	
Block	( )	800	( )	150'	( )	No. of Baths	(2)
Precast	(✓)	900	( )	175'	( )	Dishwasher	( )
		1000	(✓)	200'	( )	Garbage Grdr.	( )
		1100	( )	225'	(✓)	Auto-Washer	(✓)
		1200	( )	250'	( )	Other	
		Other		Other			

NOTIFY HEALTH DEPARTMENT AT LEAST EIGHT HOURS BEFORE TANK IS TO BE INSPECTED.

Final Inspection 7-26 1963 Approved (✓) Disapproved ( )

Remarks well 75'

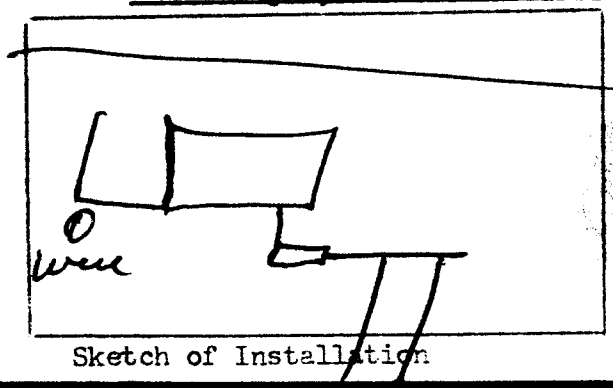

Sketch of Installation

Sanitarian