IREDELL COUNTY HEALTH DEPARTMENT STATESVILLE 704-878-5305 MOORESVILLE 704-664-5281

IMPROVEMENT PERMIT / AUTHORIZATION TO CONSTRUCT / OPERATION PERMIT / EXISTING SYSTEM INSPECTION

PERMIT # Repair PIN # 4746 94 9994 DATE 19 Dec 08

OWNER or APPLICANT William Mantz PHONE: Business Home:

OWNER or APPLICANT ADDRESS 150 Carl austin, RD

LOCATION / DIRECTIONS 21N TR Jane Sowers TR Carl austin 150 Carl austin

SUBDIVISION Danberry Forest BLOCK / SECTION LOT # 16 LOT AREA DESIGN FLOW Exist L.T.A.R. Exist

Septic Tank 1000 Gallons: STB Date 11-5-08

Pump Tank Gallons: P T Date

Pump Make Model Serial #

Nitrification Field No Fields No Lines Linear Feet

Trench Width 36" Max. Trench Bottom Depth Exist Gravel Depth 12"

☐ New System ☑ Repair ☐ Expansion System Type I II III IV V VI

System Description: Conventional Gravel

Repair System Description: Pump 50% Lasprid

Maintenance Agreement Required ☐ YES ☐ NO

☑ GRAVITY ☐ PRESSURE

☑ Residence No. Bedrooms 3

☐ Business No. Persons

☐ Other No. Employees

☐ Slab ☐ Crawl Space

☐ Basement w/plumbing ☐ Basement w/o plumbing

Water Supply: ☐ Private ☐ Public ☐ Community


Comments / Conditions

Danbury RD

Comments / Conditions

TL#1055

INITIAL SITE SKETCH

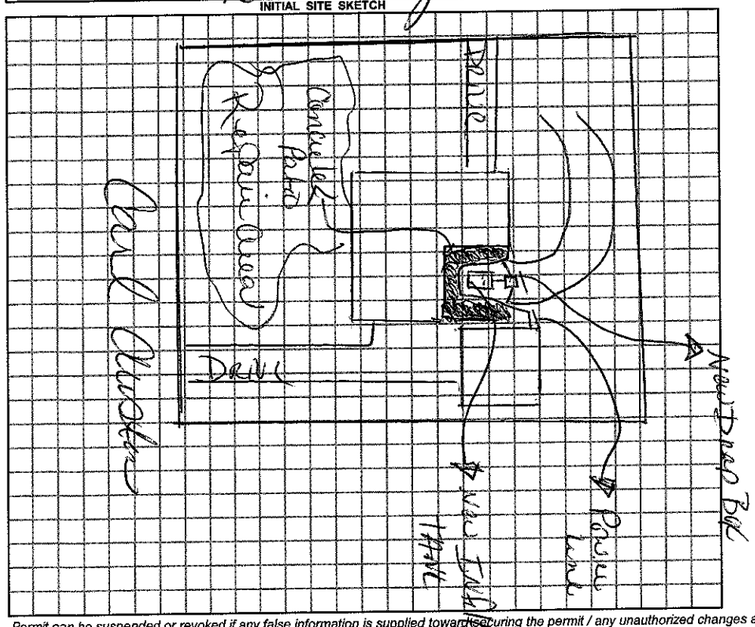

AS BUILT SKETCH

Permit can be suspended or revoked if any false information is supplied toward securing the permit / any unauthorized changes are made to the site / any unauthorized changes are made in the installation of the system.

☐ *IMPROVEMENT PERMIT w / plat valid without expiration.* ☐ *IMPROVEMENT PERMIT w / site plan valid for 60 mos.* ☑ *AUTHORIZATION TO CONSTRUCT valid for period equal to IMPROVEMENT PERMIT-not to exceed 60 mo.*

Owner / Applicant Signature: Date

Improvement Permit by: Date 19 Dec 08

Authorization to Construct by: Date 19 Dec 08

YOU SHOULD CONTACT A LOCATOR SERVICE PRIOR TO ANY EXCAVATION.

Installed by: Madison Grading

Operation Permit by: Date: 19 Dec 08

Existing System Inspected by: Date:

WHITE COPY Environmental Health YELLOW COPY (Final) Owner / Applicant PINK COPY (Initial) Owner / Applicant