IREDELL COUNTY HEALTH DEPARTMENT

STATESVILLE 704-878-5305 (CI) MOORESVILLE 704-664-5281

IMPROVEMENT PERMIT / AUTHORIZATION TO CONSTRUCT / OPERATION PERMIT / EXISTING SYSTEM INSPECTION

PERMIT# 13349520 PIN# 4746952688 DATE 4-3-06

OWNER OR APPLICANT Kenny Natley PHONE: Business 704 876 1111 Home

ADDRESS 145 Auction Ln

LOCATION I-77 N, exit 54, right onto Turnersburg Hwy/Hwy 21, R at stoplight into Ark Auction, fork to right and all the way to end

SUBDIVISION n/a BLOCK / SECTION n/a LOT n/a LOT AREA 11.669 SITE CLASS. PS DESIGN FLOW 100 GPD L.T.A.R. .3

Septic Tank: 1000 Gallons; STB 1007 Date 3-6-06
Pump Tank: Gallons; PT Date
Pump Make: Model Serial No.
Nitrification Field: No Fields 1 Square Feet Linear Feet 84
No Lines 2 Trench Width 3' Max Trench Bottom Depth 36" Gravel Depth

☒ New System ☐ Repair ☐ Expansion System Type: I II III IV V VI
System Description: 25% Reduction (II)
Repair System Description: 25% Reduction
Maintenance Agreement Required: ☐ Yes ☒ No

☒ House/Mod. Home ☐ Mobile Home ☒ Business ☐ Other
No. Bedrooms No. Persons No. Employees 2


Water Supply: ☐ Individual ☒ Public ☐ Community

☒ Gravity ☐ Pressure ☐ Slab ☒ Crawl Space ☐ Basement w/plumbing ☐ Basement wo/plumbing


Comments/Conditions: Divert water runoff away from system

Comments/Conditions:

INITIAL SITE SKETCH

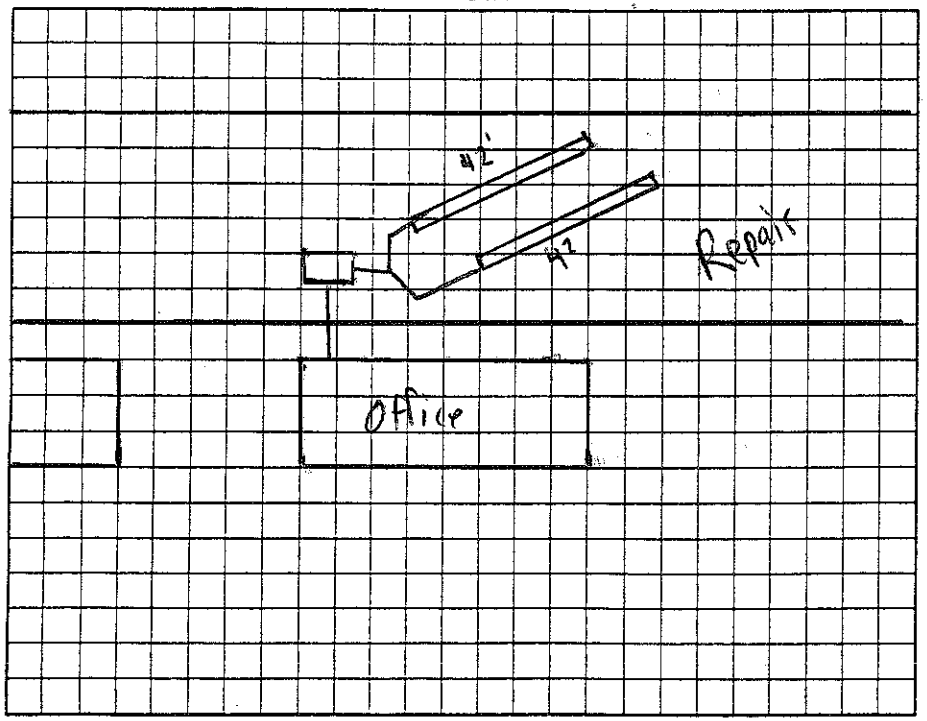

AS BUILT SKETCH

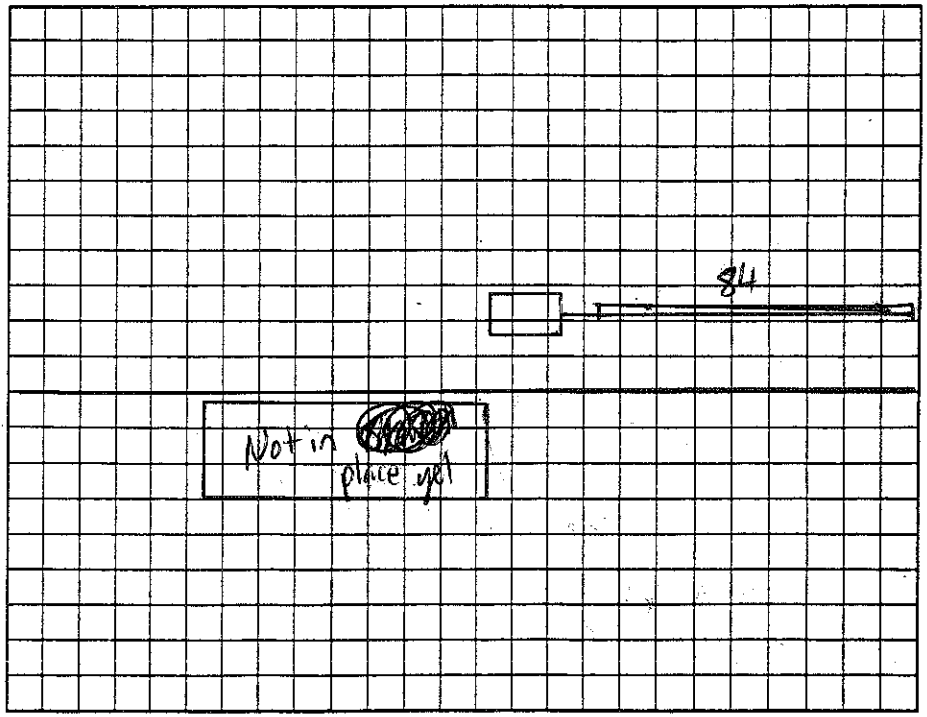

Permit can be suspended or revoked if any false information is supplied toward securing the permit/any unauthorized changes are made to the site/any unauthorized changes are made in the installation of the system. Improvement Permit with plat valid without expiration. ☐ Improvement Permit with site plan valid for sixty months ☒ Authorization to Construct is valid for a period equal to that of Improvement Permit – not to exceed sixty months.

Signed: Jennifer Staley date 4-10-06

Improvement Permit by: James Kluttz date 4-3-06

Authorization to Construct by: James Kluttz date 4-3-06

Installed by: (2) Koops Water Service

Operation Permit by: James Kluttz date 4-13-06

Existing System Inspection by: date

HEALTH DEPT. COPY: WHITE OWNER COPY (FINAL): YELLOW OWNER COPY (INITIAL): PINK