IREDELL COUNTY HEALTH DEPARTMENT

STATESVILLE 704-878-5305 (CI) MOORESVILLE 704-664-5281

IMPROVEMENT PERMIT / AUTHORIZATION TO CONSTRUCT / OPERATION PERMIT / EXISTING SYSTEM INSPECTION

PERMIT# 133493 PIN# 4746963557 DATE 4-3-06

OWNER OR APPLICANT Kenny Navey PHONE: Business 704 876 1111 Home

ADDRESS 145 Auction Lane

LOCATION 21 N, right on Auction Ln, 2 modular units at rear of property

SUBDIVISION n/a BLOCK / SECTION n/a LOT n/a LOT AREA 14.20 Acres SITE CLASS. RS DESIGN FLOW 100 GPD L.T.A.R. .3

Septic Tank: 1000 Gallons: STB 1007 Date 3-6-06
Pump Tank: Gallons: PT Date
Pump Make: Model Serial No.
Nitrification Field: No Fields 1 Square Feet Linear Feet 84
No Lines 2 Trench Width 3' Max Trench Bottom Depth 36"

☒ New System ☐ Repair ☐ Expansion System Type: I (II) III IV V VI
System Description: 25% Reduction
Repair System Description: Pump 25% Reduction
Maintenance Agreement Required: ☐ Yes ☒ No

☐ House/Mod. Home No. Bedrooms
☐ Mobile Home No. Persons
☒ Business No. Employees 2
☐ Other


Water Supply: ☐ Individual ☒ Public ☐ Community

Gravel Depth n/a ☒ Gravity ☐ Pressure ☐ Slab ☒ Crawl Space ☐ Basement w/plumbing ☐ Basement wo/plumbing


Comments/Conditions: Divert water runoff away from system

Comments/Conditions:

INITIAL SITE SKETCH

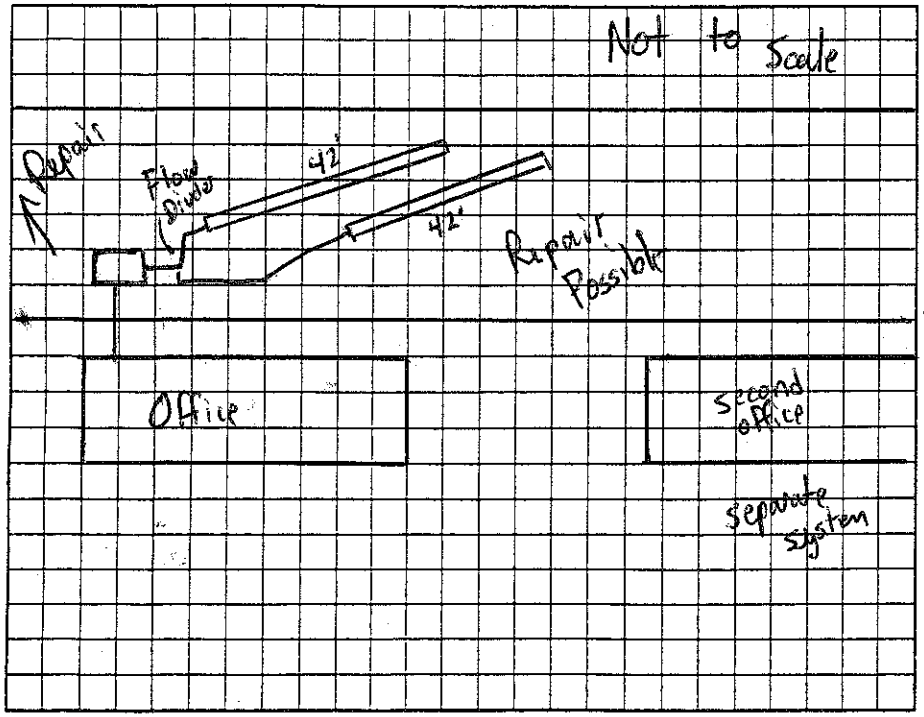

AS BUILT SKETCH

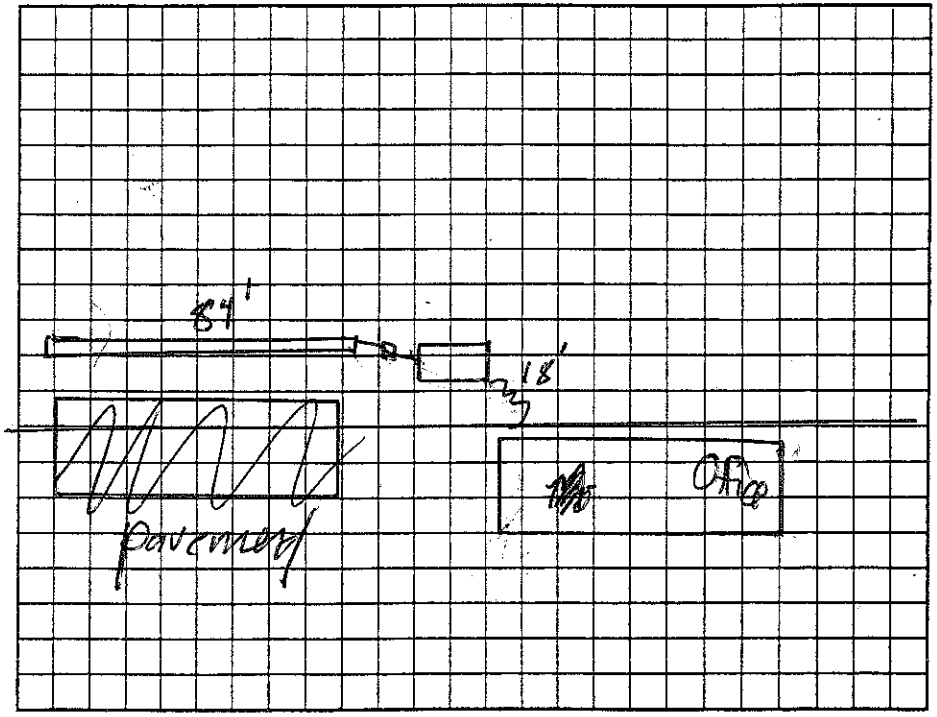

Permit can be suspended or revoked if any false information is supplied toward securing the permit/any unauthorized changes are made to the site/any unauthorized changes are made in the installation of the system. Improvement Permit with plat valid without expiration ☐ Improvement Permit with site plan valid for sixty months ☒ Authorization to Construct is valid for a period equal to that of Improvement Permit – not to exceed sixty months.

Signed: Jennifer Stacy date 4-11-06 Installed by: Reep's Water Service

Improvement Permit by: James Keen date 4-3-06 Operation Permit by: date 11/13/06

Authorization to Construct by: James Keen date 4-3-06 Existing System Inspection by: date

HEALTH DEPT. COPY: WHITE OWNER COPY (FINAL): YELLOW OWNER COPY (INITIAL): PINK