IREDELL COUNTY HEALTH DEPARTMENT

STATESVILLE 704-878-5305 MOORESVILLE 704-664-5281

IMPROVEMENT PERMIT / AUTHORIZATION TO CONSTRUCT / OPERATION PERMIT / EXISTING SYSTEM INSPECTION

PERMIT# 91597 PIN# 4756978912 DATE 8-31-00

OWNER OR CONTRACTOR Statesville Auto Auction PHONE: Business 876-1111 Home

ADDRESS 145 Auction LN Statesville, N.C.

LOCATION on Southwest Cornor of Statesville Auto Auction Property

SUBDIVISION BLOCK / SECTION LOT LOT AREA 47 acres SITE CLASS PS DESIGN FLOW 250 L.T.A.R. .3 gal/sq ft/day

Septic Tank: 1000 Gallons; STB 1012 Date 7-15-00
Pump Tank: Gallons; PT Date
Pump Make: Model Serial No.
Nitrification Field: No Fields 1 Square Feet 810 Linear Feet 270
No Lines 3 Trench Width 36" Max Trench Bottom Depth 36" Gravel Depth 12"

☒ New System ☐ Repair System Type: I II III IV V VI
System Description: Conv. Gravity
Repair System Description:
Maintenance Agreement Required: ☐ Yes ☒ No

☐ House/Mod. Home No. Bedrooms
☐ Mobile Home No. Bathrooms
☐ Business No. Employees 10
☒ Other Office for Inspection Team


☐ Slab ☒ Crawl Space ☐ Basement w/plumbing ☐ Basement wo/plumbing

Water Supply: ☐ Individual ☒ Public ☐ Community


Comments/Conditions:

Comments/Conditions: SEPTIC TANK W/ RISERS INSTALLED USING "POLYLOK" FILTER (2) SYSTEM INSTALLED AS SHOWN BELOW DUE TO HUGE HEAD SLOPE

INITIAL SITE SKETCH

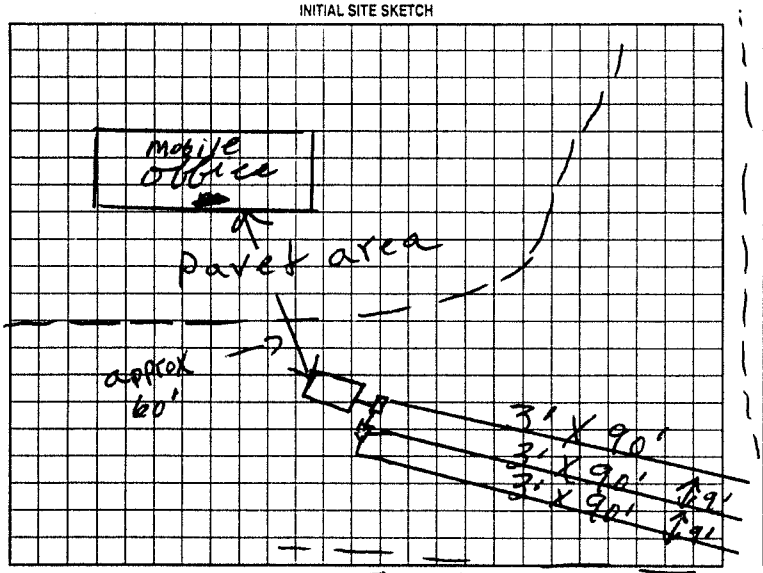

AS BUILT SKETCH

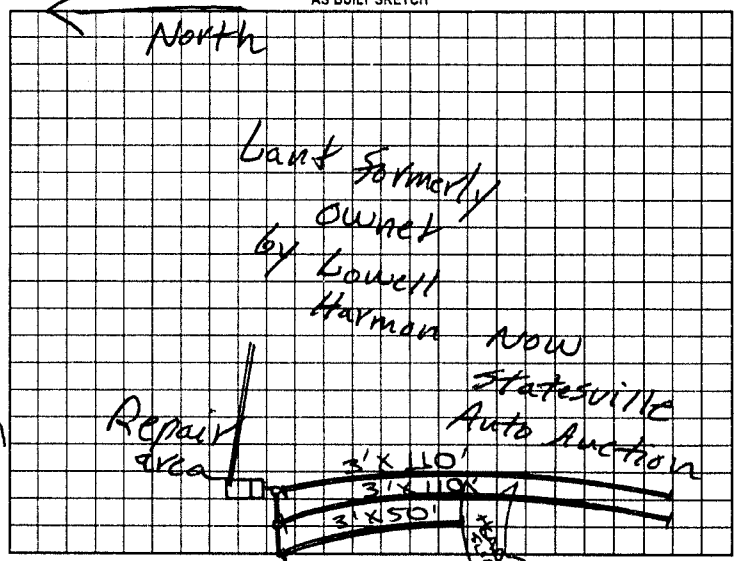

Permit can be suspended or revoked if any false information is supplied toward securing the permit/any unauthorized changes are made to the site/any unauthorized changes are made in the installation of the system. Improvement Permit with plat valid without expiration. Improvement Permit with site plan valid for sixty months. Authorization to Construct is valid for a period equal to that of Improvement Permit – not to exceed sixty months.

Signed: X. Jerry W. Taylor for property date Installed by: A-1 BACKHOE

Improvement Permit by: J. C. Moore date 8-31-00 Operation Permit by: STEVE HEDRICK date 9-8-00

Authorization to Construct by: J. C. Moore date 8-31-00 Existing System Inspection by: date

HEALTH DEPT. COPY: WHITE OWNER COPY (FINAL): YELLOW OWNER COPY (INITIAL): PINK