IREDELL COUNTY HEALTH DEPARTMENT

Statesville Phone TR 3-7271 Mooresville Phone No. 664-5281

PERMIT TO INSTALL SEPTIC TANK

Permit No. _____ Permit Date 5-24 1973

Owner Quality Oil Co Address P.O. Box 2736 Winston Salem N.C.

Installed By Self. Address _____


Location of Property Hwy 21 N. at Jennings Rd. Service Station

Tank		Capacity		Length of Lines		Fixtures	
Block	( )	1000	(✓)	225'	( )	No. of Baths	(2)
Precast	(✓)	1250	( )	250'	( )	Dishwasher	( )
		1500	( )	Other 289' 773.94 ft		Garbage Grdr.	( )
		Other _____				Other _____	

NOTIFY HEALTH DEPARTMENT AT LEAST EIGHT HOURS BEFORE TANK IS TO BE INSPECTED.

Final Inspection 5-24 1973 Approved (✓) Disapproved ( )

Remarks Iredell Water Corp.

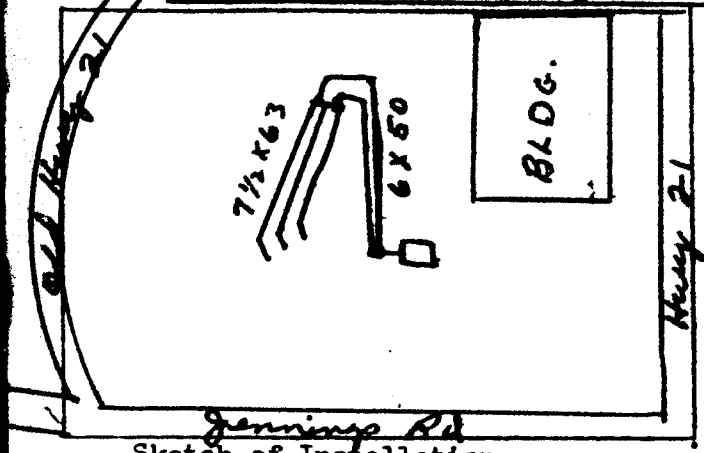

Sketch of Installation

No Cars will be Washed.

20" Stone used under lines

75 Ton used on Job.

Layout approved by Mr Hall.

E. A. Stevenson

Sanitarian