IREDELL COUNTY HEALTH DEPARTMENT

STATESVILLE 704-878-5305 MOORESVILLE 704-664-5281

IMPROVEMENT PERMIT / CERTIFICATE OF COMPLETION / OPERATION PERMIT / EXISTING SYSTEM INSPECTION

PROPERTY DESCRIPTION NO. 22087 DATE 9-12-95 TAX MAP NO. 10L-A-14 Watershed: ☒ Yes ☒ No

OWNER OR CONTRACTOR ELMER G. ALLEN, JR PHONE: Business 873-9099 Home 872-3148

ADDRESS 1820 COUNCIL AVE, STATESVILLE, NC 28677

LOCATION US 21 N, TL JENNINGS RD, TL WHITES FARM TR DIETZ ROAD, AT END ON RIGHT

SUBDIVISION _____ BLOCK / SECTION _____ LOT _____ LOT AREA 28.14 ACRES SITE CLASS. FS DESIGN FLOW 360 L.T.A.R. 0.3 GPD/FT²

Septic Tank: 1000 Gallons; STB 1012 Date 5-26-96

Pump Tank: _____ Gallons; PT _____ Date _____

Pump Make: _____ Model _____ Serial No. _____

Nitrification Field: No Fields 1 Square Feet 1200 Linear Feet 400

No Lines 4 Trench Width 36" Max Trench Bottom Depth 18-36" Gravel Depth 12"

☒ New System ☐ Repair System Type: I, ☒ II, IV, V, VI

System Description: CONVENTIONAL GRAVITY

Repair System Description: CONV. GRAVITY

Maintenance Agreement Required: ☐ Yes ☒ No

☒ House/Mod. Home No. Bedrooms 3

☐ Mobile Home No. Bathrooms 2

☐ Business No. Employees ____

☐ Other _____


☐ Slab ☒ Crawl Space ☒ Basement w/plumbing ☐ Basement wo/plumbing

Water Supply: ☒ Individual ☐ Community ☐ Public WELL


Comments: ① KEEP SYSTEM MINIMUM 100' FROM WELL. ② INSTALL LINES ON CONTOUR, NO DEEPER THAN 36", 9' MINIMUM APART ON CENTERS,

Comments:

INITIAL SITE SKETCH

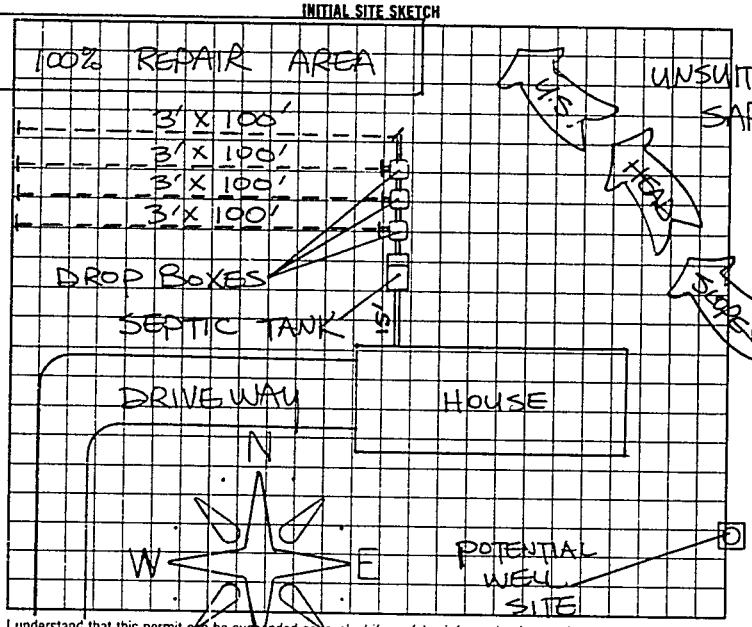

AS BUILT SKETCH

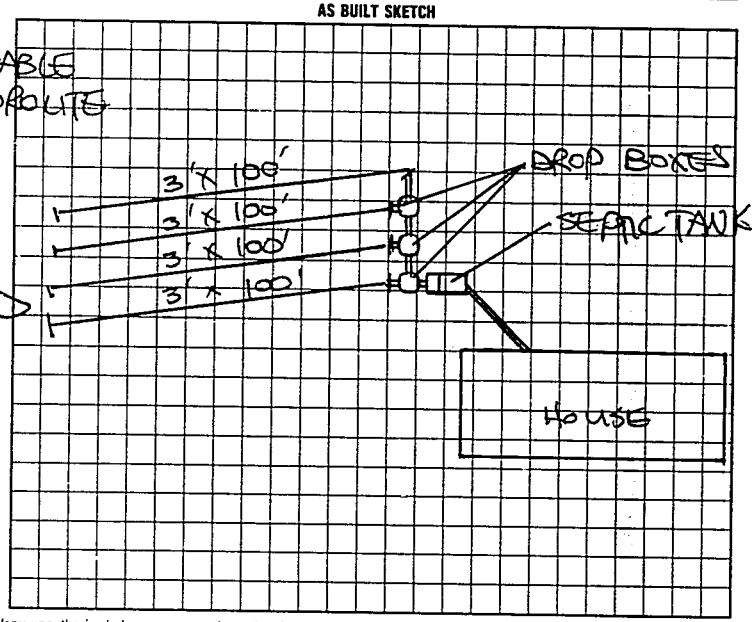

I understand that this permit can be suspended or revoked if any false information is supplied toward securing the permit/any unauthorized changes are made to the site/any unauthorized changes are made in the installation of the system.

Signed: Elmer G. Allen Jr.

Improvement Permit by: STEVE HEDRICK date 9-12-95

Existing System Inspection by: _____ date _____

Installed by: DAVID YOUNTZ

Certificate of Completion by: _____ date _____

Operation Permit by: STEVE HEDRICK date 8-20-96

HEALTH DEPT COPY WHITE INSPECTION COPY (FINAL) GREEN OWNER COPY (FINAL) YELLOW INSPECTION COPY (INITIAL) PINK OWNER COPY (INITIAL) GOLD