1:30

IREDELL COUNTY HEALTH DEPARTMENT

STATESVILLE 704-878-5305 MOORESVILLE 704-664-5281

IMPROVEMENT PERMIT / AUTHORIZATION TO CONSTRUCT / OPERATION PERMIT / EXISTING SYSTEM INSPECTION

PERMIT # 15744720 PIN # 4747-29-1827 DATE 7-21-09

OWNER or APPLICANT Dixie Land Inc. PHONE: Business 706-202-4971 Home: 704-876-6627

OWNER or APPLICANT ADDRESS 162 Sycamore Circle Statesville NC 28625

LOCATION / DIRECTIONS 21 South to Jennings Road, 2½ mile to Deer Haven Drive go on R Lot is R on corner Single Family Dwelling

SUBDIVISION Deer Crossing BLOCK / SECTION 3 4 LOT # 56 LOT AREA 0.25 Ac DESIGN FLOW 360 gpd L.T.A.R. 0.25 gpd/sf

Deer Haven Drive

Septic Tank 1000 Gallons: STB 825 Date 8-05-09

Pump Tank ____ Gallons: P T ____ Date ____

Pump Make ____ Model ____ Serial # ____

Nitrification Field No Fields 1 No Lines 3 Linear Feet 360

Trench Width 3'11" Max. Trench Bottom Depth 24" Gravel Depth N/A

☒ New System ☐ Repair ☐ Expansion System Type II (III) IV V VI

System Description: 25% Reduction - Gravity

Repair System Description: 25% Reduction - Gravity

Maintenance Agreement Required ☐ YES ☒ NO

☒ GRAVITY ☐ PRESSURE

☒ Residence No. Bedrooms 3

☐ Business No. Persons ____

☐ Other No. Employees ____

☐ Slab ☒ Crawl Space

☐ Basement w/plumbing ☐ Basement w/o plumbing

Water Supply: ☐ Private ☒ Public ☐ Community

Comments / Conditions

Please see Site Sketch for Septic Tank System Layout

Comments / Conditions

Blue Filter

INITIAL SITE SKETCH

(1) Note: Stay 15' below drainage way with nitrification fields. Note (2) Shallow Soils (soil depth less than 25" from corner of house to first Nitrification Trench.

AS BUILT SKETCH

As shown on diagram

Permit can be suspended or revoked if any false information is supplied toward securing the permit / any unauthorized changes are made to the site / any unauthorized changes are made in the installation of the system.

☐ *IMPROVEMENT PERMIT w / plat valid without expiration.* ☒ *IMPROVEMENT PERMIT w / site plan valid for 60 mos.* ☒ *AUTHORIZATION TO CONSTRUCT valid for period equal to IMPROVEMENT PERMIT-not to exceed 60 mo.*

Owner / Applicant Signature: Donna Dowdle Date 8/3/09

Improvement Permit by: Ted Clemmer Date 7-21-09

Authorization to Construct by: Ted Clemmer Date 7-21-09

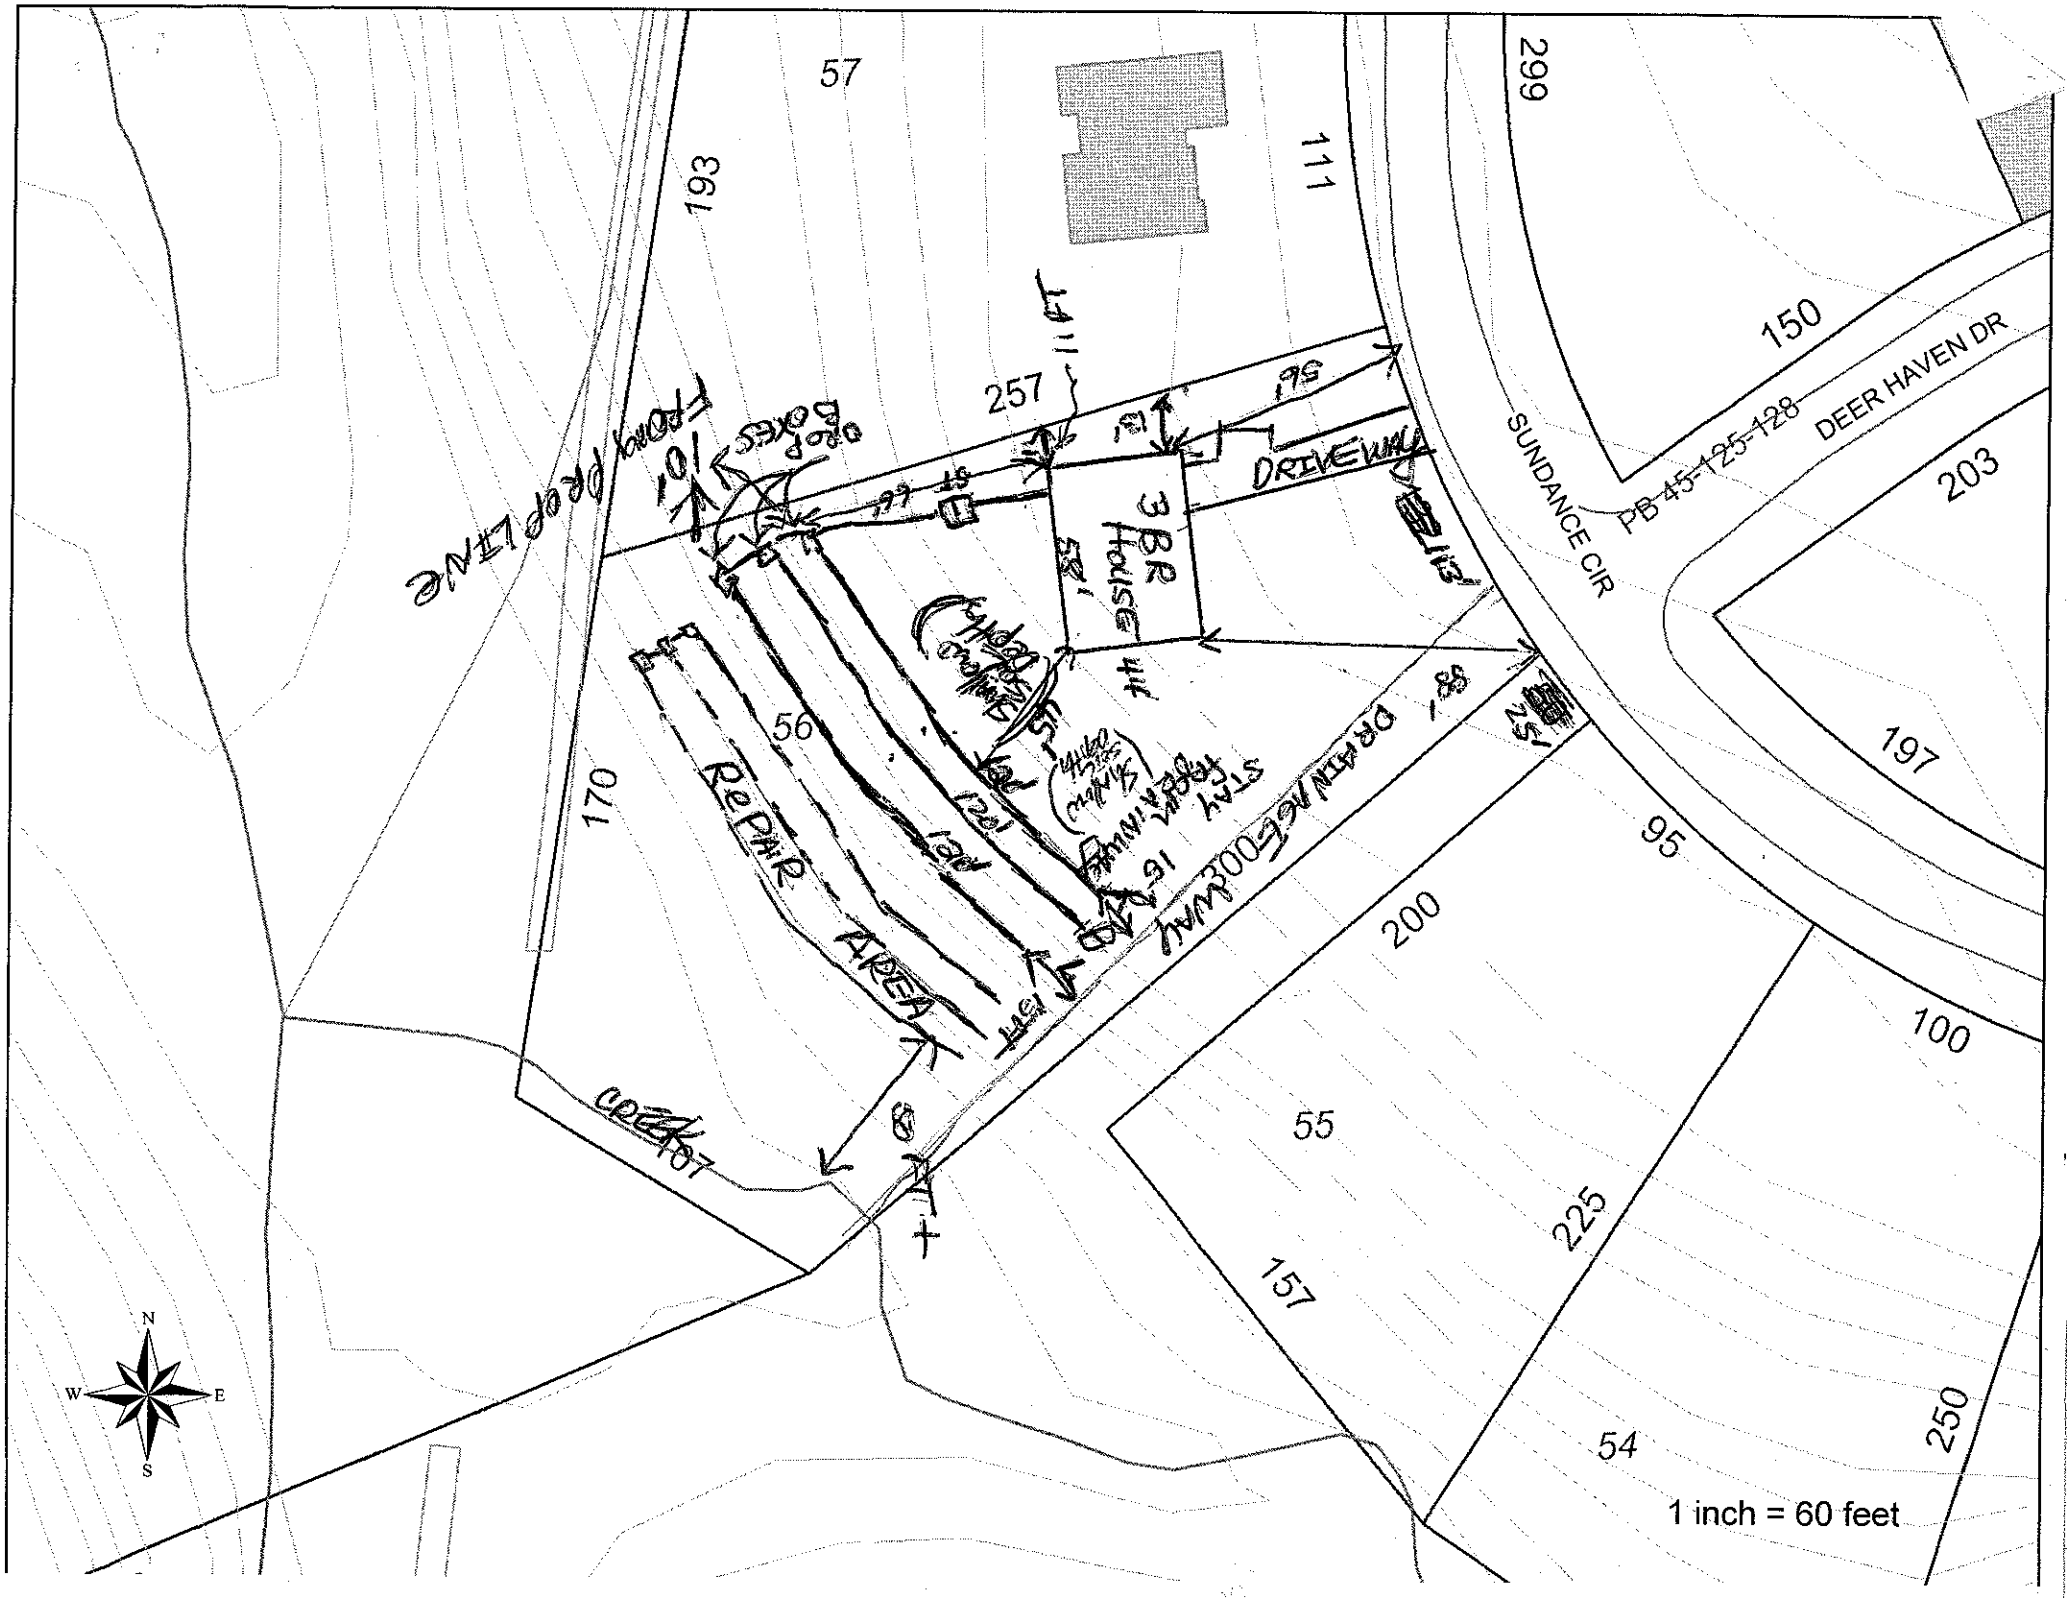
YOU SHOULD CONTACT A LOCATOR SERVICE PRIOR TO ANY EXCAVATION.

Installed by: Rowan Septic

Operation Permit by: James Date: 9-10-09

Existing System Inspected by: ____ Date: ____

WHITE COPY Environmental Health YELLOW COPY (Final) Owner / Applicant PINK COPY (Initial) Owner / Applicant


57
193
111
299
150
DEER HAVEN DR
PB 45-125-128
SUNDANCE CIR
203
197
95
257
DRIVEWAY
3BR House
56
REPAIR AREA
200
100
55
225
157
54
250
170
1 inch = 60 feet
N
W
E
S