IREDELL COUNTY HEALTH DEPARTMENT

Statesville Office (704) 878-5305 Mooresville Office (704) 660-3625 PERMIT # 20265

IMPROVEMENT PERMIT / AUTHORIZATION TO CONSTRUCT / OPERATION PERMIT / EXISTING SYSTEM

PIN # 4747295603

APPLICANT: Dixieland Construction INC APPLICANT ADDRESS: 133 Redemption Rd

SITE ADDRESS: 153 Sundance Cir. PHONE: 704-202-4971 ALT. PHONE: N/A

SITE DIRECTIONS: HWY 21N TL Jennings Rd TL Deer Haven TL Sundance Cir

SUBDIVISION: Deer Crossing SECTION: PH2 LOT # 53 LOT AREA: 0.64 acres DESIGN FLOW: 360gpd L.T.A.R.: 0.3

Septic Tank 1000 (gal) STB 1012-1660 Date 4-1-14
Pump Tank (gal) PT Date
Pump Make Model Serial #
Nitrification Fields 1 # Lines 4 Linear Ft: 200
Trench Width 24" Max. Trench Bottom Depth 36" Gravel Depth N/A

☑ New System ☐ Repair ☐ Expansion System Type: I II III IV V VI
System Description: PPBPS
Repair System Description: Low Pressure PPBPS
Maintenance Agreement Required: ☐ YES ☑ NO
☑ GRAVITY ☐ PRESSURE


☑ Residence No. Bedrooms 3
☐ Business No. Persons 6
☐ Other No. Employees
☐ Slab ☑ Crawl Space
☐ Basement w/plumbing ☐ Basement w/o plumbing

Water Supply: ☐ Private ☑ Public ☐ Community

Comments / Conditions: IMPROVEMENTS ONLY! Combine Lots Prior to issuance of CA. Install a PPBPS system on contour with Parallel distribution, utilizing an effluent splitter such as Zoellar. Install 44 total Panels

-Lots were combined 6-5-14 & CA issued 6-6-14

INITIAL SITE SKETCH

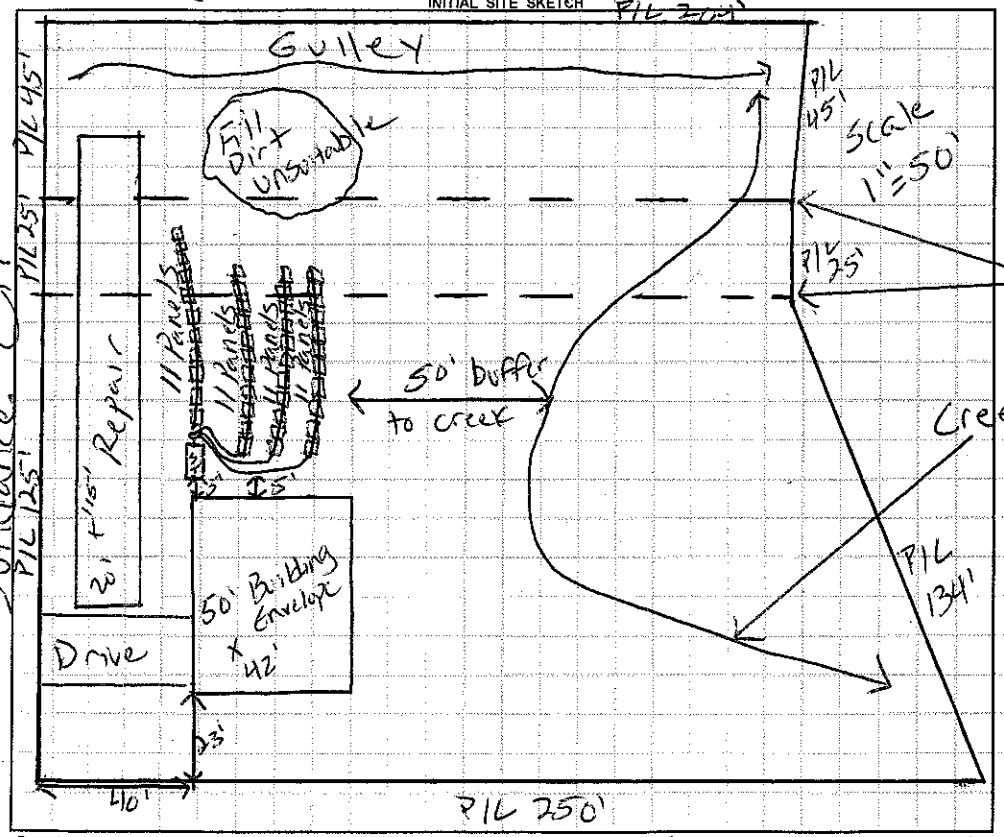

AS BUILT SKETCH

- Yellow Tuf-Rite filters installed
- 7" PVC S.T. marker installed
- Installed as drawn

Permit can be suspended or revoked if any false information is supplied toward securing the permit / any unauthorized changes are made to the site / any unauthorized changes are made in the installation of the system. **CONTACT A LOCATOR SERVICE PRIOR TO ANY EXCAVATION**

☐ **IMPROVEMENT PERMIT *with plat*** *valid without expiration.* ☑ **IMPROVEMENT PERMIT *with site plan*** *valid for 60 mos.* ☑ **AUTHORIZATION TO CONSTRUCT** *valid for period equal to IMPROVEMENT PERMIT--not to exceed 60 mo.*

Owner / Applicant Signature: Teresa Randle Date: 6/6/14 Installed by: Steve Jordan

IMPROVEMENT PERMIT by: Justin Henderson Date: 6-2-14 OPERATION PERMIT by: Justin Henderson Date: 9-4-14

AUTHORIZATION TO CONSTRUCT by: Justin Henderson Date: 6-6-14 Existing System Inspected by: Date:

Health Dept. Copy - WHITE Applicant (Final Approval) - YELLOW Applicant (Conditional Approval) - PINK