IREDELL COUNTY HEALTH DEPARTMENT

STATESVILLE 704-878-5305 (ot) MOORESVILLE 704-664-5281

IMPROVEMENT PERMIT / AUTHORIZATION TO CONSTRUCT / OPERATION PERMIT / EXISTING SYSTEM INSPECTION

PERMIT# 143196 PIN# 4747296818 DATE 7-17-07

OWNER OR APPLICANT Dixieland PHONE: Business 704 202 4971 Home 704 376 6162

ADDRESS 154 Sundance Circle

LOCATION Jennings Rd (L) on Deer Haven, Left on Sundance

SUBDIVISION Deer Crossing BLOCK / SECTION 4 LOT 82 LOT AREA .47 SITE CLASS. PS DESIGN FLOW 360 L.T.A.R. .3

Septic Tank: 1000 Gallons; STB 825 Date 7-1-07
Pump Tank: 1000 Gallons; PT 307 Date 2-10-05
Pump Make: _____ Model _____ Serial No. _____
Nitrification Field: No Fields 1 Square Feet 1200 Linear Feet 300
No Lines 4 Trench Width 36" Max Trench Bottom Depth 36"

☐ New System ☐ Repair ☐ Expansion System Type: I II III IV V VI
System Description: 25% Pump Reduction
Repair System Description: 50% LP Reduction
Maintenance Agreement Required: ☐ Yes ☒ No

☒ House/Mod. Home No. Bedrooms 3
☐ Mobile Home No. Persons ____
☐ Business No. Employees ____
☐ Other _____


Water Supply: ☐ Individual ☒ Public ☐ Community

Gravel Depth _____ ☐ Gravity ☒ Pressure ☐ Slab ☒ Crawl Space ☐ Basement w/plumbing ☐ Basement wo/plumbing


Comments:/Conditions:

Comments:/Conditions:
Blue Tuf-Tite Filler

INITIAL SITE SKETCH

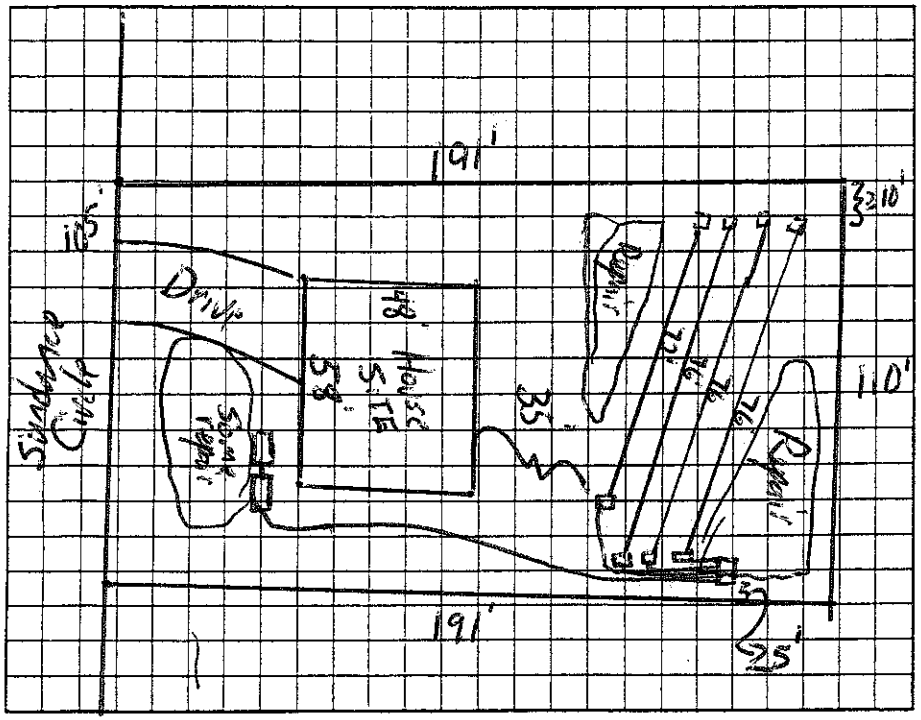

AS BUILT SKETCH

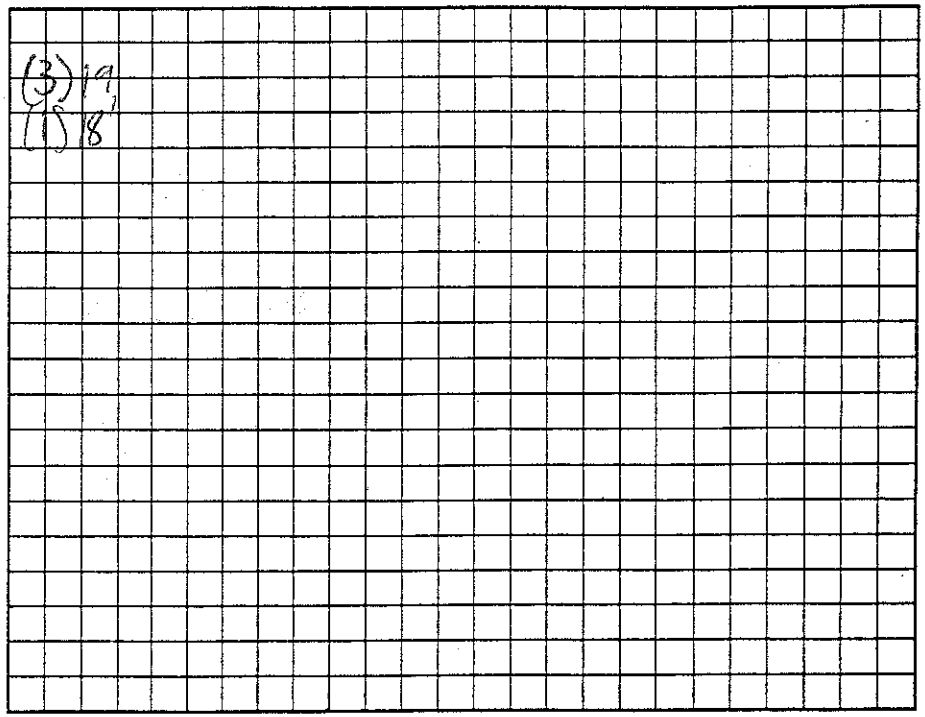

Permit can be suspended or revoked if any false information is supplied toward securing the permit/any unauthorized changes are made to the site/any unauthorized changes are made in the installation of the system. Improvement Permit with plat valid without expiration. ☐ Improvement Permit with site plan valid for sixty months ☒ Authorization to Construct is valid for a period equal to that of Improvement Permit – not to exceed sixty months.

Signed: Tonya Daniels date 7/19/07
Improvement Permit by: _____ date 7-17-07
Authorization to Construct by: _____ date 7-17-07

Installed by: _____
Operation Permit by: _____ date 8/7/08
Existing System Inspection by: _____ date _____

HEALTH DEPT. COPY: WHITE OWNER COPY (FINAL): YELLOW OWNER COPY (INITIAL): PINK