IREDELL COUNTY HEALTH DEPARTMENT

STATESVILLE 704-878-5305 CI MOORESVILLE 704-664-5281

IMPROVEMENT PERMIT / AUTHORIZATION TO CONSTRUCT / OPERATION PERMIT / EXISTING SYSTEM INSPECTION

PERMIT# 139269 PIN# 4747297805 DATE 12-14-06

OWNER OR APPLICANT Dixieland Inc. PHONE: Business 704 202 4971 Home 704 876 6162

ADDRESS 150 Sundance Circle

LOCATION Hwy 21 to (L) on Jennings (L) into Deer Crossing (L) into Sundance Circle property on right

SUBDIVISION Deer Crossing BLOCK / SECTION 4 LOT 83 LOT AREA SITE CLASS. R5 DESIGN FLOW 320 L.T.A.R. .3

Septic Tank: 1000 Gallons; STB 825-1000 Date 10-3-07
Pump Tank: 1000 Gallons; PT 302 Date 9-21-07
Pump Make: Zoeller Model M152 Serial No.
Nitrification Field: No Fields 1 Square Feet 1200 Linear Feet 300
No Lines 4 Trench Width 36" Max Trench Bottom Depth 36"

☒ New System ☐ Repair ☐ Expansion System Type: I (II) III IV V VI
System Description: 25% Reduction pump
Repair System Description: 50% LP fuel
Maintenance Agreement Required: ☐ Yes ☒ No

☒ House/Mod. Home No. Bedrooms 3
☐ Mobile Home No. Persons
☐ Business No. Employees
☐ Other


Water Supply: ☐ Individual ☒ Public ☐ Community

Gravel Depth n/a ☒ Gravity ☒ Pressure ☐ Slab ☒ Crawl Space ☐ Basement w/plumbing ☐ Basement wo/plumbing

Comments:/Conditions:

Comments:/Conditions:

INITIAL SITE SKETCH

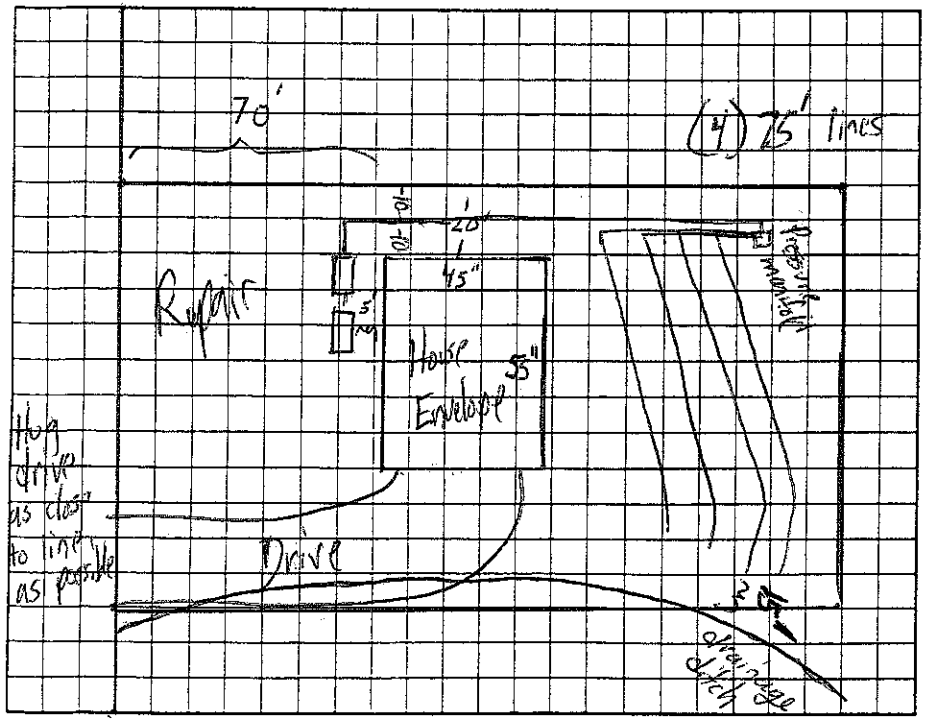

AS BUILT SKETCH

Permit can be suspended or revoked if any false information is supplied toward securing the permit/any unauthorized changes are made to the site/any unauthorized changes are made in the installation of the system. Improvement Permit with plat valid without expiration ☐ Improvement Permit with site plan valid for sixty months ☑ Authorization to Construct is valid for a period equal to that of Improvement Permit – not to exceed sixty months.

Signed: Kenna Rowell date 12-27-06

Improvement Permit by: date 12-14-06

Authorization to Construct by: date 12-27-06

Installed by: Rowan Septic Service

Operation Permit by: date 12-7-07

Existing System Inspection by: date

HEALTH DEPT. COPY: WHITE OWNER COPY (FINAL): YELLOW OWNER COPY (INITIAL): PINK