IREDELL COUNTY HEALTH DEPARTMENT

STATESVILLE 704-878-5305 (ar) (ar) MOORESVILLE 704-664-5281

IMPROVEMENT PERMIT / AUTHORIZATION TO CONSTRUCT / OPERATION PERMIT / EXISTING SYSTEM INSPECTION

PERMIT # 15690520 PIN # 4714-29-8822 DATE 7/13/09

OWNER or APPLICANT Dixie Land Construction Inc. PHONE: Business (704)-202-4977 Home: 4 Lot go left

OWNER or APPLICANT ADDRESS 146 Dundee Circle Statesville NC 28625

LOCATION / DIRECTIONS Hwy 21 North to Jennings Road go 1.5 mile to Deerhaven Dr to Sandmire Circle

SUBDIVISION Deer Crossing BLOCK / SECTION 3 4 LOT # 84 LOT AREA 0.76 ac DESIGN FLOW 360 gpd/day BDR. 0.3 gpd/ft² Mary

Septic Tank	1000	Gallons: STB	825	Date	4-29		
Pump Tank	1000	Gallons: PT	302	Date	5-6-09		
Pump Make		Model		Serial #			
Nitrification Field	No Fields 1	No Lines 4	Linear Feet 300				
Trench Width	36"	Max. Trench Bottom Depth	36	Gravel Depth	N/A		

☒ New System ☐ Repair ☐ Expansion System Type ☐ II ☐ III ☐ IV ☐ V ☐ VI

System Description: 25% Reduction

Repair System Description: 25% OR 50% Red.

Maintenance Agreement Required ☐ YES ☒ NO

☐ GRAVITY ☒ PRESSURE

☒ Residence No. Bedrooms 3

☐ Business No. Persons 6

☐ Other No. Employees

☐ Slab ☒ Crawl Space


☐ Basement w/plumbing ☐ Basement w/o plumbing

Water Supply: ☐ Private ☒ Public ☐ Community

Comments / Conditions


See attached site sketch

INITIAL SITE SKETCH

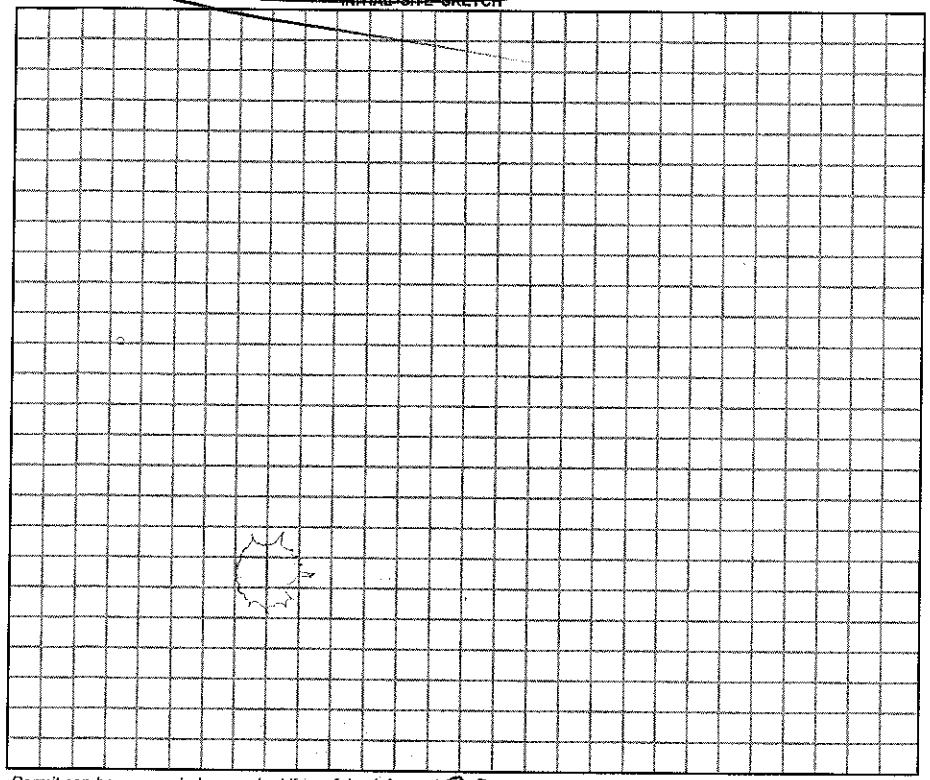

Comments / Conditions

AS BUILT SKETCH

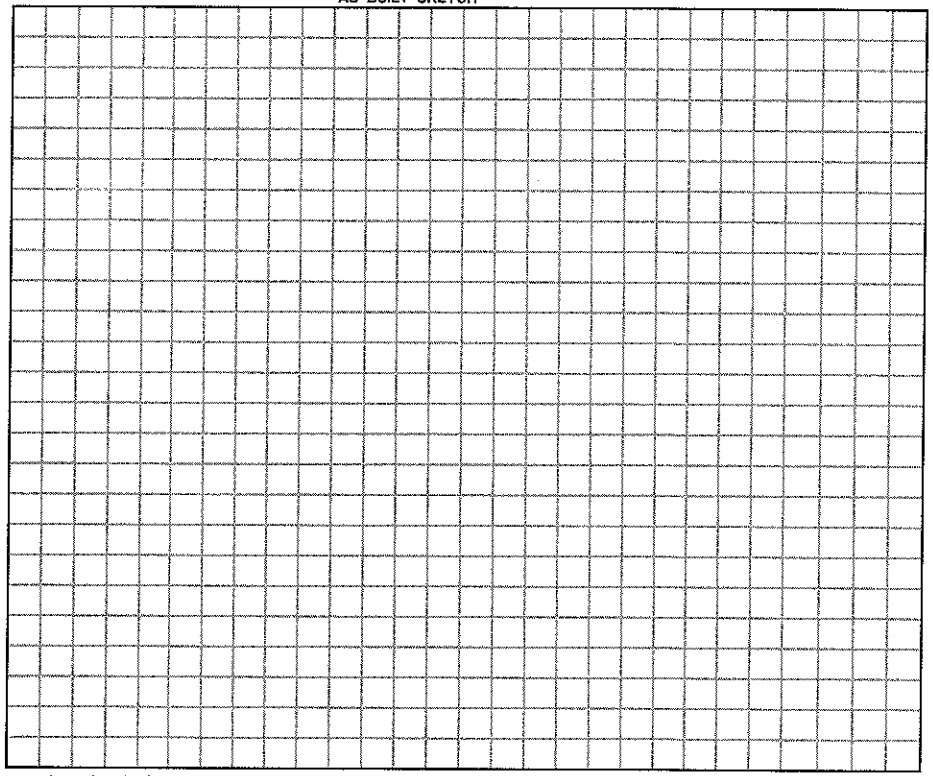

Permit can be suspended or revoked if any false information is supplied toward securing the permit / any unauthorized changes are made to the site / any unauthorized changes are made in the installation of the system.

☒ *IMPROVEMENT PERMIT w / plat valid without expiration.* ☐ *IMPROVEMENT PERMIT w / site plan valid for 60 mos.* ☒ *AUTHORIZATION TO CONSTRUCT valid for period equal to IMPROVEMENT PERMIT-not to exceed 60 mo.*

Owner / Applicant Signature: [signature] Date 7-20-09

Improvement Permit by: Fred Clemmer Date 7-15-09

Authorization to Construct by: Fred Clemmer Date 7-16-09


YOU SHOULD CONTACT A LOCATOR SERVICE PRIOR TO ANY EXCAVATION.

Installed by: Lowan Septic

Operation Permit by: [signature] Date: 11-5-09

Existing System Inspected by: Date:

WHITE COPY Environmental Health YELLOW COPY (Final) Owner / Applicant PINK COPY (Initial) Owner / Applicant

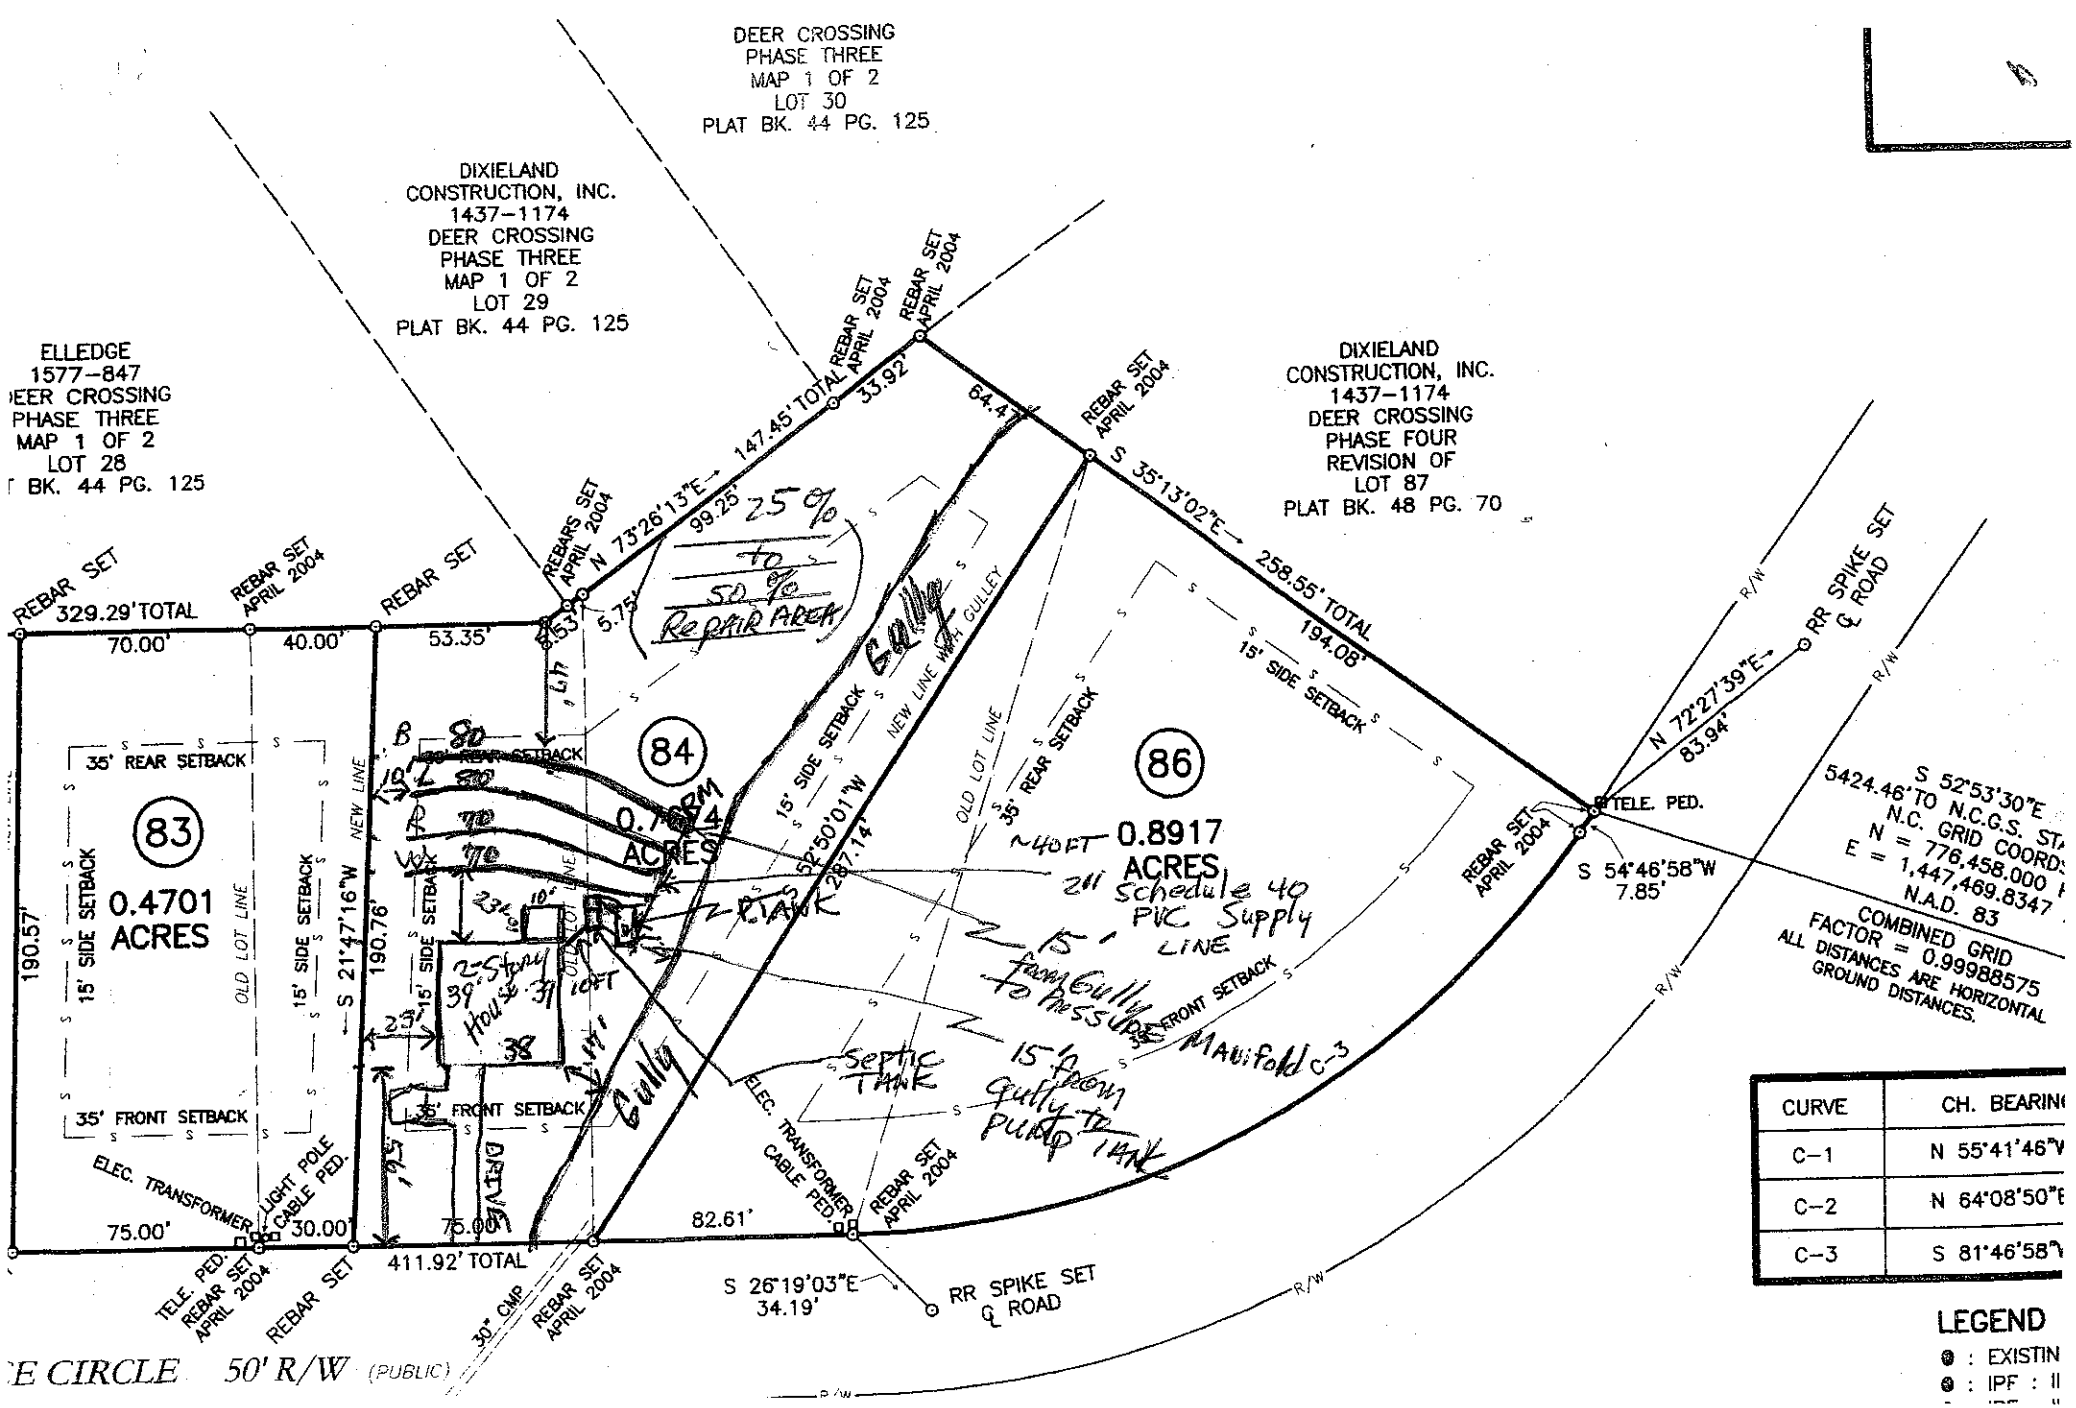

Dixie Road Construction, Inc.
Lot 84 Section 3
Deer Crossing 5/0