See attached permit #162898 for pool addition.

IREDELL COUNTY HEALTH DEPARTMENT

STATESVILLE 704-878-5305 MOORESVILLE 704-664-5281

IMPROVEMENT PERMIT / AUTHORIZATION TO CONSTRUCT / OPERATION PERMIT / EXISTING SYSTEM INSPECTION

PERMIT# 147465 PIN# 4747329846

OWNER OR APPLICANT KW Nicholson Inc. PHONE: Business 704 902 0799 Home DATE 1-28-08

ADDRESS 166 Doe Run Trl

LOCATION 21 N. (L) on Shoemaker Dr., Turn into Whites Farm Road (L) on Doe Run Lot on left

SUBDIVISION Graystone Meadows BLOCK / SECTION LOT 38 LOT AREA 145 x 300 SITE CLASS. PS DESIGN FLOW 480 L.T.A.R. .3

Septic Tank: 1000 Gallons: STB 1012 Date 10-3-07

Pump Tank: Gallons: PT Date

Pump Make: Model Serial No.

Nitrification Field: No Fields 1 Square Feet 1600 Linear Feet 400

No Lines 5 Trench Width 36" Max Trench Bottom Depth 36" Gravel Depth Gravity ☐ Pressure

☒ New System ☐ Repair ☐ Expansion System Type: I II III IV V VI

System Description: 25% Reduction Gravity

Repair System Description: 25% Reduction (pump if nec.)

Maintenance Agreement Required: ☐ Yes ☒ No

☒ House/Mod. Home ☐ Mobile Home ☐ Business ☐ Other

No. Bedrooms 4 No. Persons No. Employees

Water Supply: ☐ Individual ☒ Public ☐ Community


☒ Slab ☐ Crawl Space ☐ Basement w/plumbing ☐ Basement wo/plumbing

Comments:/Conditions:


(5) 3' x 80'

Comments:/Conditions:

INITIAL SITE SKETCH

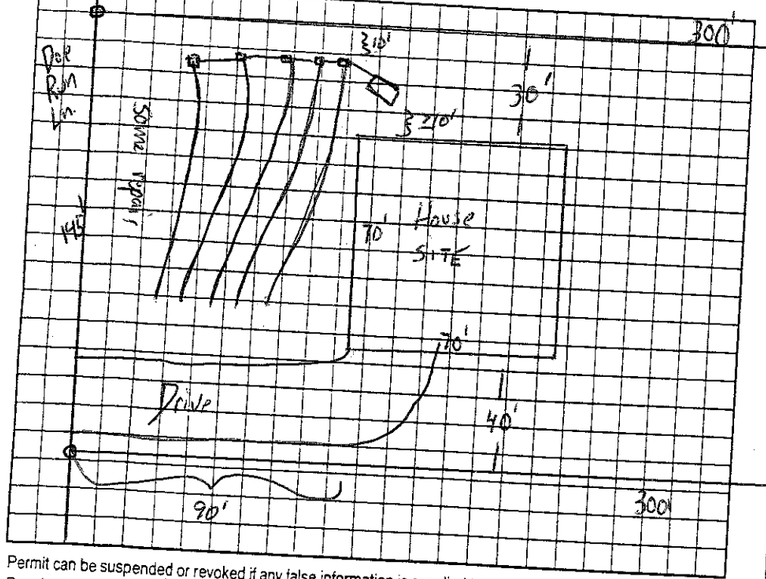

AS BUILT SKETCH

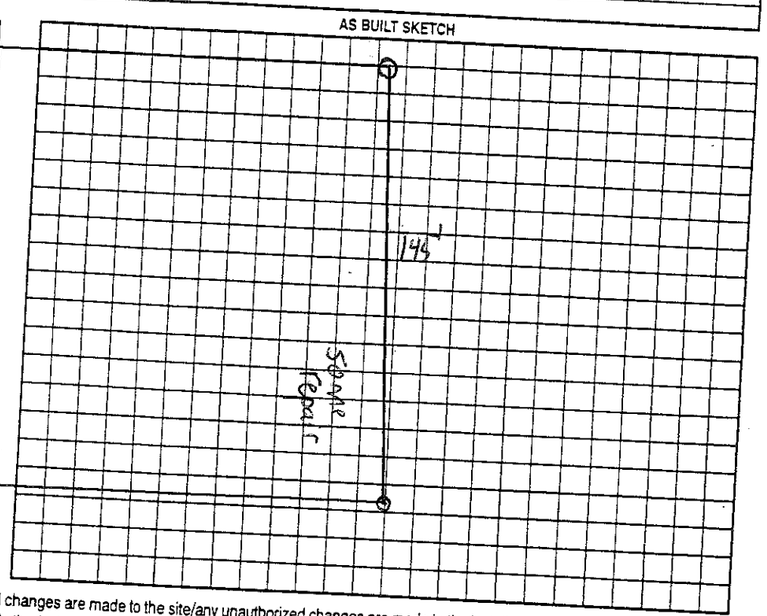

Permit can be suspended or revoked if any false information is supplied toward securing the permit/any unauthorized changes are made to the site/any unauthorized changes are made in the installation of the system. Improvement Permit with plat valid without expiration ☐ Improvement Permit with site plan valid for sixty months ☒ Authorization to Construct is valid for a period equal to that of Improvement Permit – not to exceed sixty months.

Signed:

Improvement Permit by: date 1-29-08

Authorization to Construct by: date 1-28-08

Installed by: David Hunt date 1-28-08

Operation Permit by: date 7-2-08

Existing System Inspection by: date

HEALTH DEPT. COPY: WHITE OWNER COPY (FINAL): YELLOW OWNER COPY (INITIAL): PINK