IREDELL COUNTY HEALTH DEPARTMENT

STATESVILLE 704-878-5305 MOORESVILLE 704-664-5281

+100 52304

IMPROVEMENT PERMIT / CERTIFICATE OF COMPLETION / OPERATION PERMIT / EXISTING SYSTEM INSPECTION

PROPERTY DESCRIPTION NO. 19094 DATE 6-23-94 TAX MAP NO. 10F-5-A-17 Watershed: ☐ Yes ☑ No

OWNER OR CONTRACTOR Gary Hawks PHONE: Business Home 872-8468

ADDRESS Statesville N.C

LOCATION 21N TL Shoemaker Dr. TO White's Farm Rd TR DOG RUN LN TR FOX GLOVE TR Pheasant Ln on L

SUBDIVISION Greystone meadows BLOCK / SECTION LOT 17 LOT AREA 155'X283' SITE CLASS. PS DESIGN FLOW 360 L.T.A.R. .35

Septic Tank: 1000 Gallons; STB 1012 Date 7/29/94

Pump Tank: Gallons; PT Date

Pump Make: Model Serial No.

Nitrification Field: No Fields 1 Square Feet 1035 Linear Feet 345

No Lines 3 Trench Width 36" Max Trench Bottom Depth 36" Gravel Depth 12"

☑ New System ☐ Repair System Type: I (II) III, IV, V, VI

System Description: Conv. Gravity

Repair System Description: Pump To Conv. lines

Maintenance Agreement Required: ☐ Yes ☑ No

☑ House/Mod. Home No. Bedrooms 3

☐ Mobile Home No. Bathrooms 2

☐ Business No. Employees

☐ Other


☐ Slab ☑ Crawl Space ☐ Basement w/plumbing ☐ Basement wo/plumbing

Water Supply: ☐ Individual ☐ Community ☑ Public

Comments:

155'

INITIAL SITE SKETCH

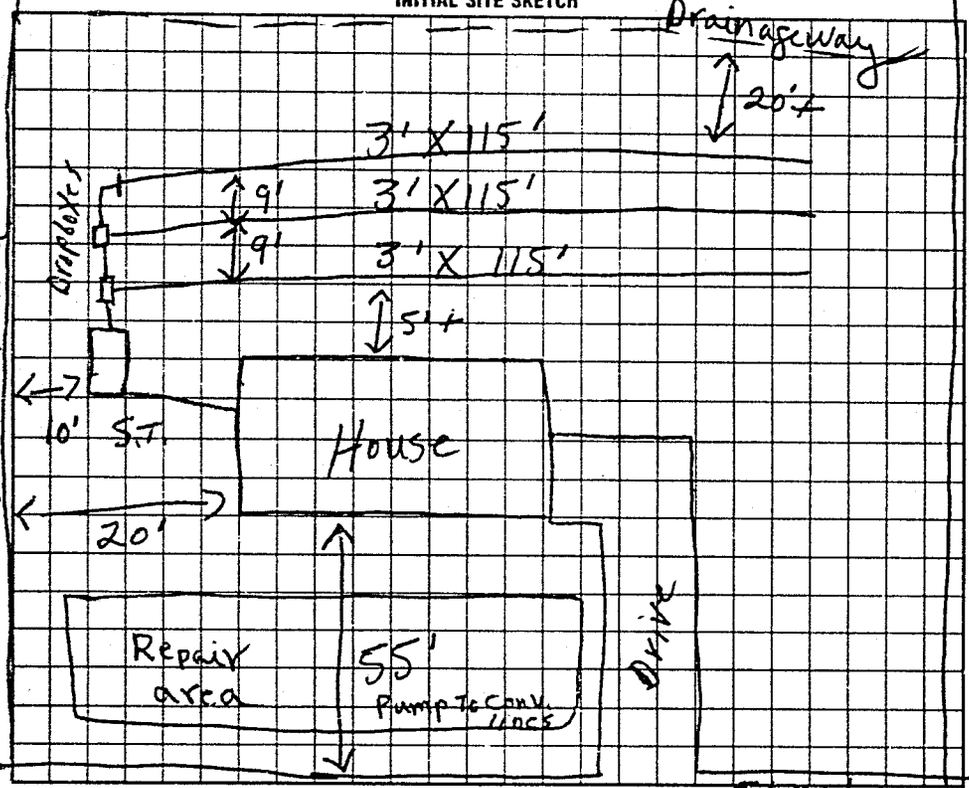

Comments:

AS BUILT SKETCH

SYSTEM INSTALLED ACCORDING TO INITIAL SITE SKETCH

I understand that this permit can be suspended or revoked if any false information is supplied toward securing the permit/any unauthorized changes are made to the site/any unauthorized changes are made in the installation of the system. Improvement Permit is valid for 60 months from date of issuance.

Signed: x Kent W Moore

Improvement Permit by: K. C. Moore date 6-23-94

Existing System Inspection by: date

Installed by: Tommy Frye

Certificate of Completion by: Steve Hendrick date 10/24/94

Operation Permit by: date

HEALTH DEPT COPY WHITE INSPECTION COPY (FINAL) GREEN OWNER COPY (FINAL) YELLOW INSPECTION COPY (INITIAL) PINK OWNER COPY (INITIAL) GOLD