IREDELL COUNTY HEALTH DEPARTMENT

STATESVILLE 704-878-5305 MOORESVILLE 704-664-5281

IMPROVEMENT PERMIT / AUTHORIZATION TO CONSTRUCT / OPERATION PERMIT / EXISTING SYSTEM INSPECTION

PERMIT# 138865 PIN# 4747338116 DATE 11/16/06

OWNER OR APPLICANT R.W. Wright Construction & Contracting PHONE: Business 704 876 6406 Home

ADDRESS 169 Foxglove Rd

LOCATION Hwy 21 N. Left Shoemaker Dr., Left on Foxglove Dr, Property on the left in the curve

SUBDIVISION Graystone Meadow BLOCK / SECTION LOT 36 LOT AREA .977 SITE CLASS. PS DESIGN FLOW 330 L.T.A.R. .3

Septic Tank: 1000 Gallons; STB 1012 Date 1-20-07

Pump Tank: Gallons; PT Date

Pump Make: Model Serial No.

Nitrification Field: No Fields 1 Square Feet 1600 Linear Feet 400

No Lines 4 Trench Width 36" Max Trench Bottom Depth 3 Gravel Depth

☒ New System ☐ Repair ☐ Expansion System Type: I II III IV V VI

System Description: 25% Reduction

Repair System Description: 25% Reduction (pump if nec.)

Maintenance Agreement Required: ☐ Yes ☒ No

☒ Gravity ☐ Pressure

☒ House/Mod. Home No. Bedrooms 4

☐ Mobile Home No. Persons

☐ Business No. Employees

☐ Other

Water Supply: ☐ Individual ☒ Public ☐ Community


☐ Slab ☐ Crawl Space ☒ Basement w/plumbing ☐ Basement wo/plumbing

Comments:/Conditions:


Comments:/Conditions:

Yellow Septic tank marker

INITIAL SITE SKETCH

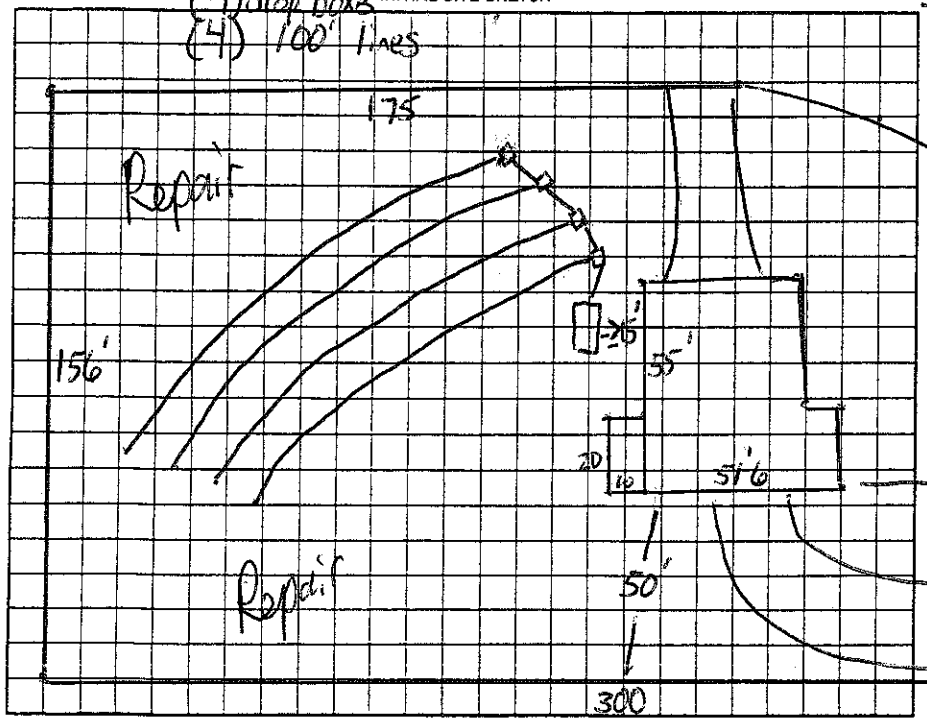

AS BUILT SKETCH

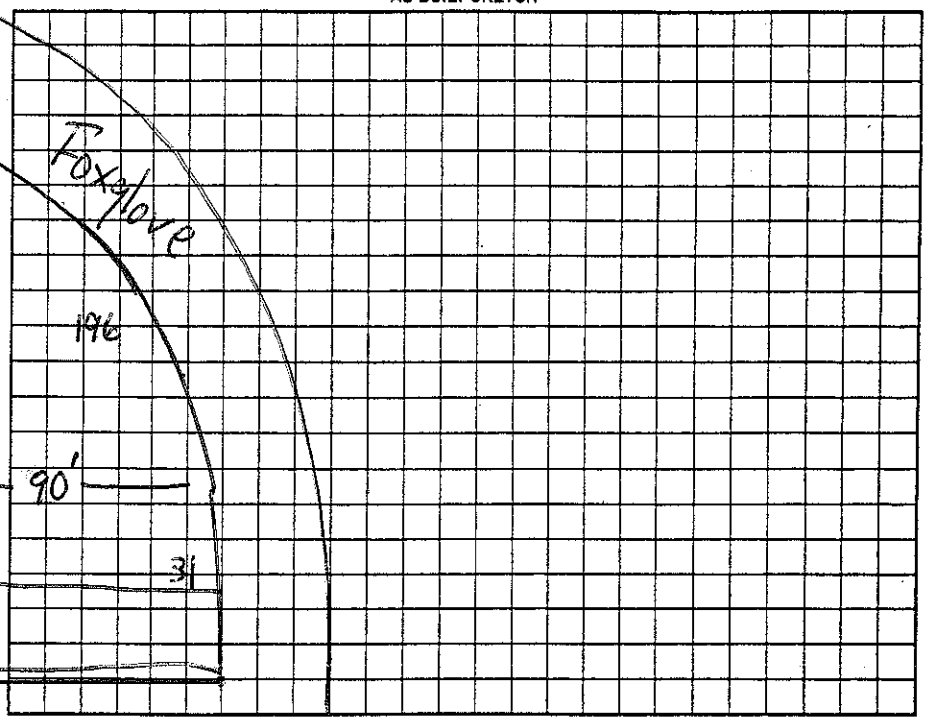

Permit can be suspended or revoked if any false information is supplied toward securing the permit/any unauthorized changes are made to the site/any unauthorized changes are made in the installation of the system. Improvement Permit with plat valid without expiration ☐ Improvement Permit with site plan valid for sixty months ☐ Authorization to Construct is valid for a period equal to that of Improvement Permit – not to exceed sixty months.

Signed: R.W. Wright date 1-12-06

Improvement Permit by: James R. Lewis date 11/16/06

Authorization to Construct by: James R. Lewis date 11/16/06

Installed by: Tommy Freye

Operation Permit by: Kelly Cook date 8-28-07

Existing System Inspection by: date

HEALTH DEPT. COPY: WHITE OWNER COPY (FINAL): YELLOW OWNER COPY (INITIAL): PINK