1138

IREDELL COUNTY HEALTH DEPARTMENT - *ENVIRONMENTAL HEALTH* ☑ STATESVILLE OFFICE 704-878-5305 ☐ MOORESVILLE OFFICE 704-664-5281

IMPROVEMENT PERMIT / AUTHORIZATION TO CONSTRUCT / OPERATION PERMIT / EXISTING SYSTEM INSPECTION

PERMIT # 169124 PIN # 4747-33-9155 DATE 15 November 11

OWNER Scott Tutterow APPLICANT: R.W. Wright PHONE: Home/Cell # (704) 437-4338 Business #

SITE ADDRESS 159 Foxglove Dr. Statesville OWNER / APPLICANT ADDRESS

SITE DIRECTIONS Jennings Rd. TL White's Farm Rd. TR Foxglove - Lot on left.

SUBDIVISION Greystone Meadows BLOCK / SECTION LOT # 35 LOT AREA 0.984 ac. DESIGN FLOW 480 g/d L.T.A.R. 0.3 g/ft²/d

Septic Tank 1000 Gallons: STB 1012 Date 2-28-12
Pump Tank Gallons: P T Date
Pump Make Model Serial #
No. Nitrification Fields: 1 No. Lines 4 Linear Feet 400
Trench Width 36" Max. Trench Bottom Depth 36" Gravel Depth N/A


☑ New System ☐ Repair ☐ Expansion System Type I II III IV V VI
System Description: 25% Reduction System
Repair System Description: 50% Reduction System.
Maintenance Agreement Required ☐ YES ☑ NO
☑ GRAVITY ☐ PRESSURE

☑ Residence No. Bedrooms 4
☐ Business No. Persons
☐ Other No. Employees
☐ Slab ☑ Crawl Space
☑ Basement w/plumbing ☐ Basement w/o plumbing


Water Supply: ☐ Private ☑ Public ☐ Community

Comments / Conditions

INITIAL SITE SKETCH

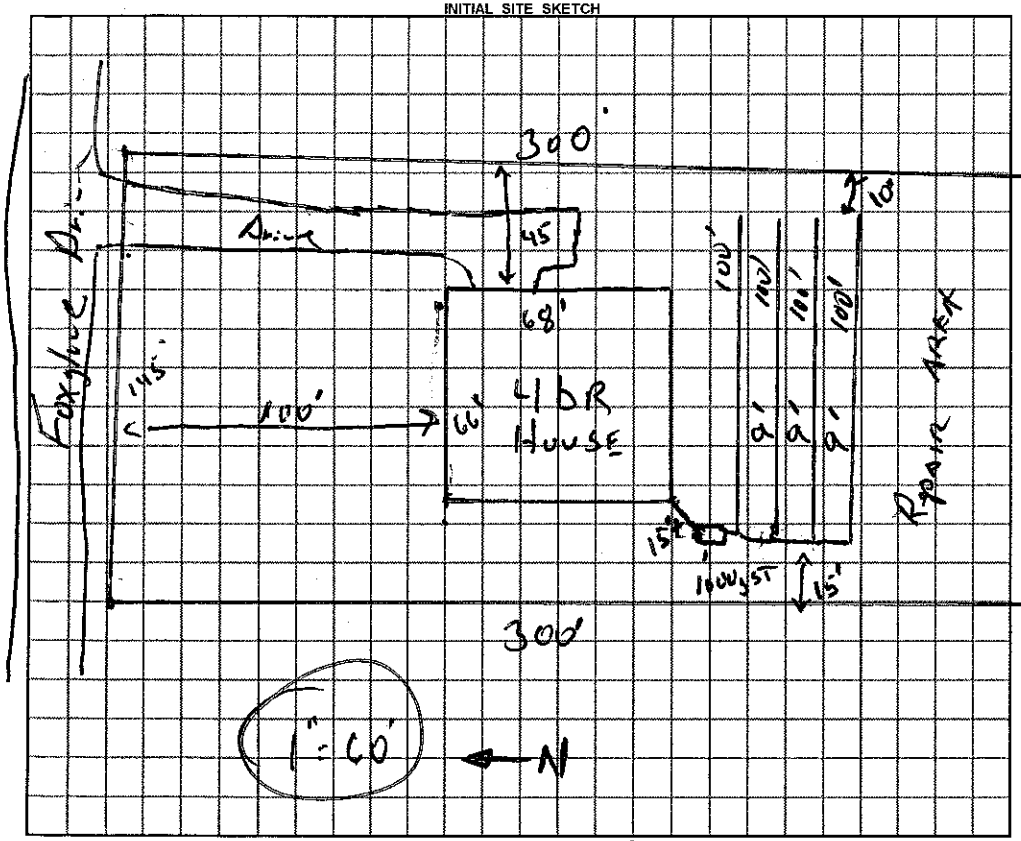

AS BUILT SKETCH

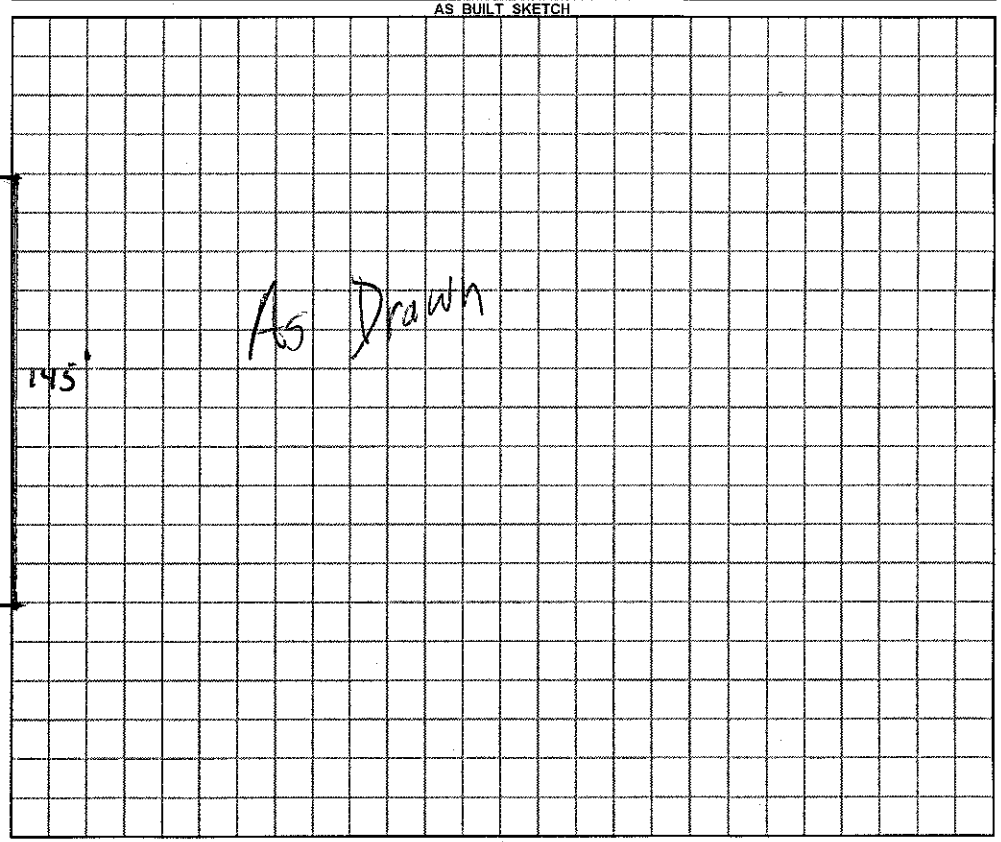

Permit can be suspended or revoked if any false information is supplied toward securing the permit / any unauthorized changes are made to the site / any unauthorized changes are made in the installation of the system.

☐ ***IMPROVEMENT PERMIT*** *with plat valid without expiration.* ☑ ***IMPROVEMENT PERMIT*** *with ~~plat valid without expiration.~~ site plan valid 60 mo.* ☑ ***AUTHORIZATION TO CONSTRUCT*** valid for period equal to IMPROVEMENT PERMIT--not to exceed 60 mo.

Owner / Applicant Signature: Kelly Wright Date 11-15-11 Installed by: David Yount

IMPROVEMENT PERMIT by: REHS Date 15 Nov. 11 OPERATION PERMIT by: REHS Date 4-25-12

AUTHORIZATION TO CONSTRUCT by: REHS Date 15 Nov 11 Existing System Inspected by: REHS Date

YOU SHOULD CONTACT A LOCATOR SERVICE PRIOR TO ANY EXCAVATION

White Copy – Environmental Health YELLOW COPY (Final) Owner / Applicant PINK COPY (Initial) Owner / Applicant