IREDELL COUNTY HEALTH DEPARTMENT (CI)

STATESVILLE 704-878-5305 MOORESVILLE 704-664-5281

IMPROVEMENT PERMIT / AUTHORIZATION TO CONSTRUCT / OPERATION PERMIT / EXISTING SYSTEM INSPECTION

PERMIT# 141041 PIN# 4747390704 DATE 3-9-07

OWNER OR APPLICANT Dixieland, Inc PHONE: Business 704 876 6162 Home 704 876 6162

ADDRESS Sundance Circle

LOCATION Jennings Rd to Deer Crossing - to end of Deer Haven - Make left - lot in curve

SUBDIVISION Deer Crossing BLOCK / SECTION 4 LOT 86 LOT AREA .892 SITE CLASS. PS DESIGN FLOW 360 L.T.A.R. .3

Septic Tank: 1000 Gallons; STB 825 Date 4-14-07
Pump Tank: ____ Gallons; PT ____ Date ____
Pump Make: ____ Model ____ Serial No. ____
Nitrification Field: No Fields 1 Square Feet 1200 Linear Feet 300
No Lines 3 Trench Width 36" Max Trench Bottom Depth 36"

☒ New System ☐ Repair ☐ Expansion System Type: I (II) III IV V VI
System Description: 25% Reduction
Repair System Description: 50% Reduction LP
Maintenance Agreement Required: ☐ Yes ☐ No
Gravel Depth N/A ☒ Gravity ☐ Pressure

☒ House/Mod. Home No. Bedrooms 3
☐ Mobile Home No. Persons ____
☐ Business No. Employees ____
☐ Other ____


Water Supply: ☐ Individual ☒ Public ☐ Community

☐ Slab ☒ Crawl Space ☐ Basement w/plumbing ☐ Basement wo/plumbing

Comments/Conditions:

Comments/Conditions:
Blue Fiber

INITIAL SITE SKETCH

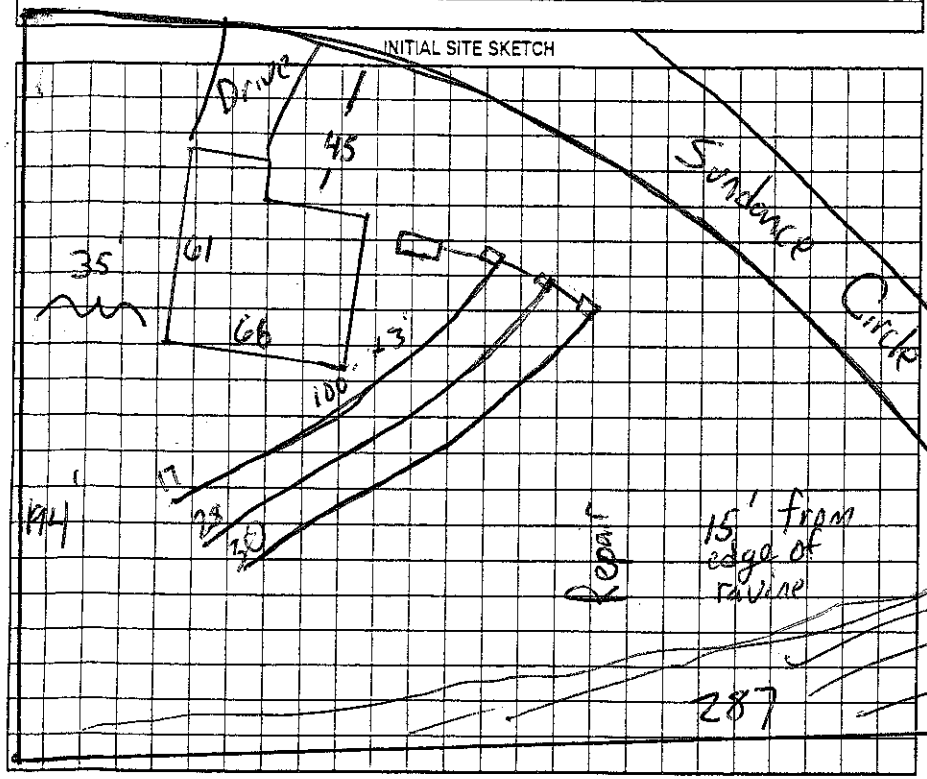

AS BUILT SKETCH

Permit can be suspended or revoked if any false information is supplied toward securing the permit/any unauthorized changes are made to the site/any unauthorized changes are made in the installation of the system. Improvement Permit with plat valid without expiration ☐ Improvement Permit with site plan valid for sixty months ☐ Authorization to Construct is valid for a period equal to that of Improvement Permit – not to exceed sixty months.

Signed: ____ date 3-12-07
Improvement Permit by: ____ date 3-04-07
Authorization to Construct by: ____ date 3-09-07

Installed by: Rowan Septic
Operation Permit by: ____ date 6-1-07
Existing System Inspection by: ____ date ____

HEALTH DEPT. COPY: WHITE OWNER COPY (FINAL): YELLOW OWNER COPY (INITIAL): PINK