IREDELL COUNTY HEALTH DEPARTMENT

STATESVILLE 704-878-5305 CT MOORESVILLE 704-664-5281

IMPROVEMENT PERMIT / AUTHORIZATION TO CONSTRUCT / OPERATION PERMIT / EXISTING SYSTEM INSPECTION

PERMIT# 132606020 PIN# 4747392849 992 DATE 12-20-05

OWNER OR CONTRACTOR Dixieland Construction PHONE: Business 704-202-4971 Home

ADDRESS 823 Jennings RD Statesville NC 28625

LOCATION 21N to Jennings RD to Deer Crossing to Sundance Circle lot on Right

SUBDIVISION Deer Crossing BLOCK / SECTION 4 LOT 88 89 LOT AREA 1.71 SITE CLASS. PS DESIGN FLOW 360 L.T.A.R. 105

Septic Tank: 1000 Gallons; STB 325 Date 1-25-06

Pump Tank: Gallons; PT Date

Pump Make: Model Serial No.

Nitrification Field: No Fields Square Feet 1440 Linear Feet 360

No Lines 5 Trench Width 36" Max Trench Bottom Depth 36" Gravel Depth N/A

☑ New System ☐ Repair System Type: I, II, III, IV, V, VI

System Description: 25% GRADE D

Repair System Description: 25% CP

Maintenance Agreement Required: ☐ Yes ☐ No ☑ Repair

☑ House/Mod. Home No. Bedrooms 3

☐ Mobile Home No. Bathrooms

☐ Business No. Employees

☐ Other


☐ Slab ☑ Crawl Space ☐ Basement w/plumbing ☐ Basement wo/plumbing

Water Supply: ☐ Individual ☑ Public ☐ Community


Comments:/Conditions: Install on Contour Maintain all setbacks

Comments:/Conditions: Blue Poly Lock Filter Septic tank Marker

INITIAL SITE SKETCH

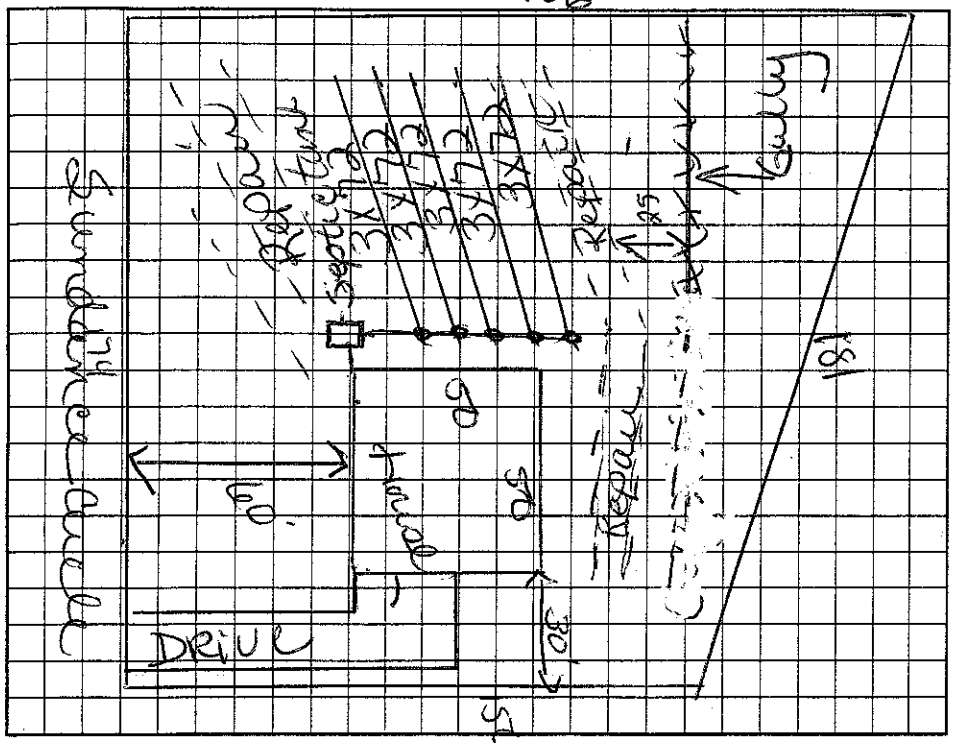

AS BUILT SKETCH

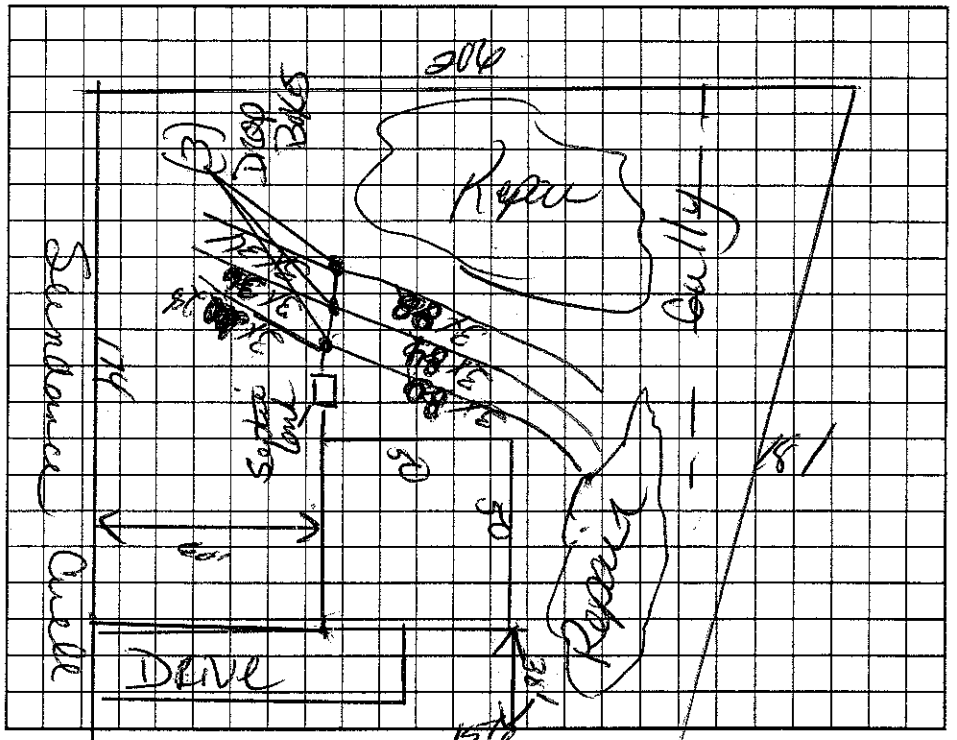

Permit can be suspended or revoked if any false information is supplied toward securing the permit/any unauthorized changes are made to the site/any unauthorized changes are made in the installation of the system. Improvement Permit with plat valid without expiration. Improvement Permit with site plan valid for sixty months. Authorization to Construct is valid for a period equal to that of Improvement Permit – not to exceed sixty months.

Signed: Regina L Cecil date 12/21/05 Installed by: Rowan Septic

Improvement Permit by: Kelly Cook date 12-20-05 Operation Permit by: Kelly Cook date 3-27-06

Authorization to Construct by: Kelly Cook date 12-20-05 Existing System Inspection by: date

HEALTH DEPT. COPY: WHITE OWNER COPY (FINAL): YELLOW OWNER COPY (INITIAL): PINK