11:00

# IREDELL COUNTY HEALTH DEPARTMENT

STATESVILLE 704-878-5305 MOORESVILLE 704-664-5281

DRAFT

## IMPROVEMENT PERMIT / AUTHORIZATION TO CONSTRUCT / OPERATION PERMIT / EXISTING SYSTEM INSPECTION

PERMIT # 161414 PIN # 4747421446 DATE 6-14-10

OWNER or APPLICANT (Tom Palmer Homes) KENNETH WEBB PHONE: Business 980 241 9693 Home:

OWNER or APPLICANT ADDRESS 157 Doe Run Ln

LOCATION / DIRECTIONS 21N; (L) Shumaker, continue onto White Farm Rd (L) onto Doe Run Lane; lot on left

SUBDIVISION Graystone Meadows BLOCK / SECTION LOT # 7 LOT AREA 1.294 DESIGN FLOW 480 L.T.A.R. .25

Septic Tank 1000 Gallons: STB 794 Date 7-10-12

Pump Tank Gallons: P T Date

Pump Make Model Serial #

Nitrification Field No Fields 1 No Lines 4 Linear Feet 480

Trench Width 36" Max. Trench Bottom Depth 36" Gravel Depth n/a

☒ New System ☐ Repair ☐ Expansion System Type I II III IV V VI

System Description: 25% Reduction Gravity

Repair System Description: 25% Reduction Gravity

Maintenance Agreement Required ☐ YES ☒ NO

☒ GRAVITY ☐ PRESSURE

☒ Residence No. Bedrooms 4 ☐ Business No. Persons ☐ Other No. Employees ☐ Slab ☒ Crawl Space ☐ Basement w/plumbing ☐ Basement w/o plumbing


Water Supply: ☐ Private ☒ Public ☐ Community

Comments / Conditions


Comments / Conditions

B1036

INITIAL SITE SKETCH

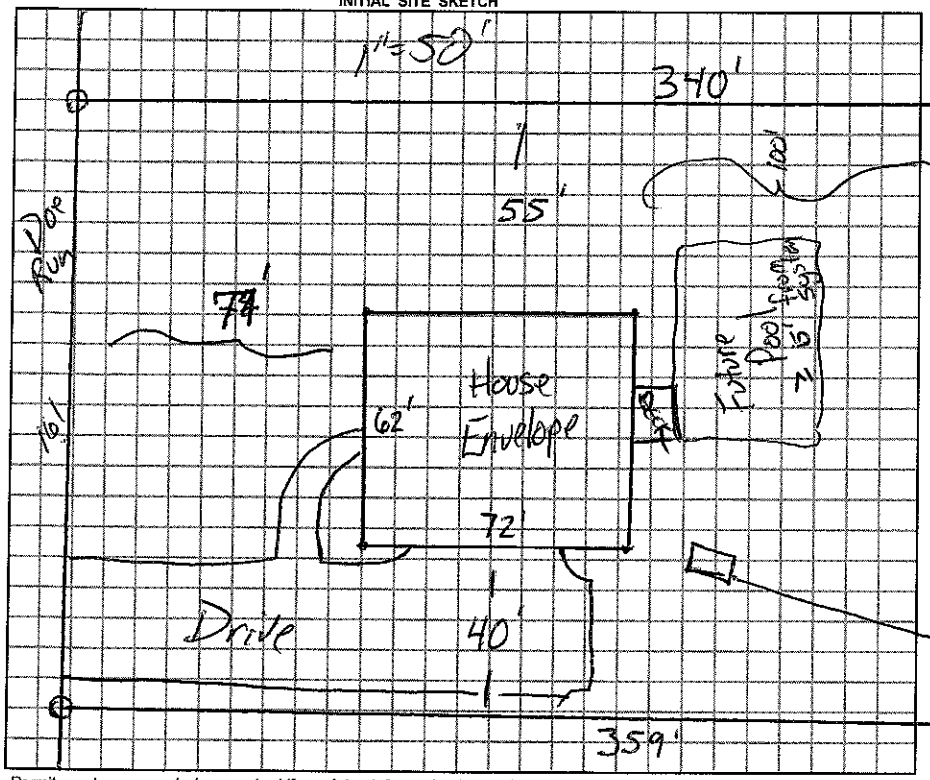


AS BUILT SKETCH

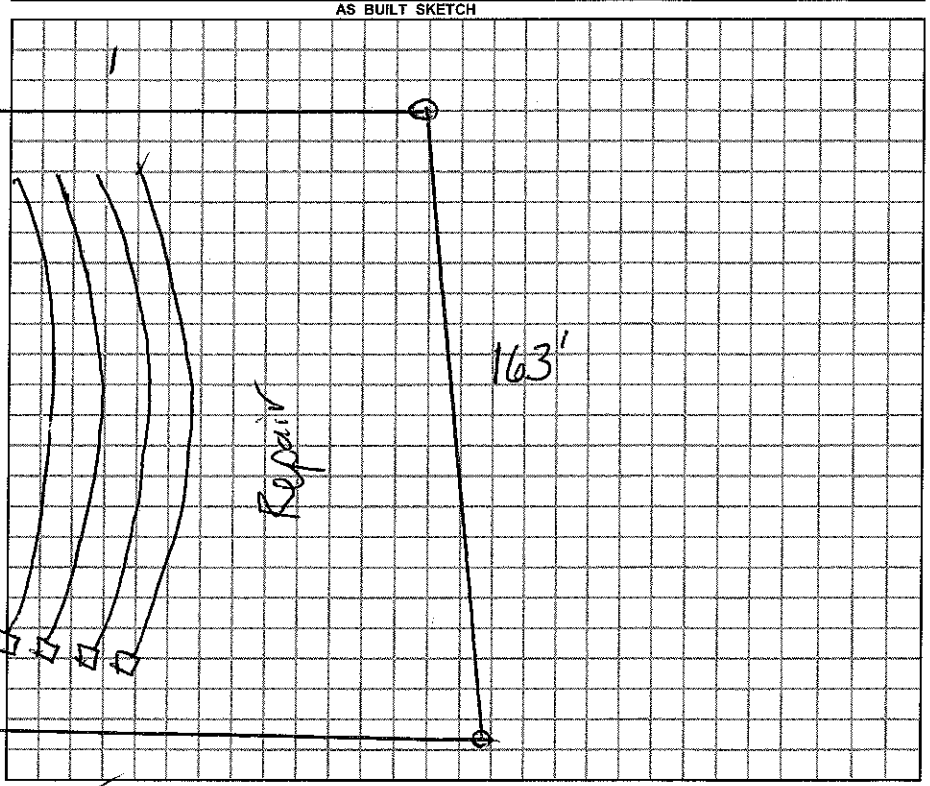


*Permit can be suspended or revoked if any false information is supplied toward securing the permit / any unauthorized changes are made to the site / any unauthorized changes are made in the installation of the system.*

☐ *IMPROVEMENT PERMIT w/ plat valid without expiration.* ☒ *IMPROVEMENT PERMIT w/ site plan valid for 60 mos.* ☑ *AUTHORIZATION TO CONSTRUCT valid for period equal to IMPROVEMENT PERMIT-not to exceed 60 mo.*

Owner / Applicant Signature: 2-17-12 Date 6-24-2010 Installed by: Hartman Const.

Improvement Permit by: James Date 6-14-10 Operation Permit by: James Date: 8-23-12

Authorzation to Construct by: R. STEVE HENDRICK Date 2-17-2012 Existing System Inspected by: Date:

**YOU SHOULD CONTACT A LOCATOR SERVICE PRIOR TO ANY EXCAVATION.**

WHITE COPY Environmental Health YELLOW COPY (Final) Owner / Applicant PINK COPY (Initial) Owner / Applicant