IREDELL COUNTY HEALTH DEPARTMENT

STATESVILLE 704-878-5305 MOORESVILLE 704-664-5281

☆ This permit replaces one issued 4-20-05 ☆ # 126798 DRT

(A) IMPROVEMENT PERMIT / AUTHORIZATION TO CONSTRUCT (B) OPERATION PERMIT (C) EXISTING SYSTEM INSPECTION

PERMIT # 16413 PIN # 4747 42 3404 DATE 6-14-10

OWNER or APPLICANT Kevin Smith (Tom Palmer Homes) PHONE: Business 980 241 9693 Home:

OWNER or APPLICANT ADDRESS 149 Doe Run Ln Statesville, NC

LOCATION / DIRECTIONS 21N; (L) Shumaker, continue onto White Farm Rd; (L) onto Doe Run Ln; lot on (L)

SUBDIVISION Graystone Meadows BLOCK / SECTION LOT # 6 LOT AREA 1.224 DESIGN FLOW 480 L.T.A.R. .25

Septic Tank 1000 Gallons: STB 822 Date 11-12-10

Pump Tank Gallons: P T Date

Pump Make Model Serial #

Nitrification Field No Fields 1 No Lines 6 Linear Feet 480

Trench Width 36" Max. Trench Bottom Depth 36" Gravel Depth n/a

☒ New System ☐ Repair ☐ Expansion System Type I II (III) IV V VI

System Description: 25% Reduction Gravity

Repair System Description: 50% Reduction LP

Maintenance Agreement Required ☐ YES ☒ NO

☒ GRAVITY ☐ PRESSURE

☒ Residence No. Bedrooms 4 ☐ Business No. Persons ☐ Other No. Employees ☐ Slab ☒ Crawl Space ☐ Basement w/plumbing ☐ Basement w/o plumbing

Water Supply: ☐ Private ☒ Public ☐ Community


Comments / Conditions

Comments / Conditions


Poly lock fittings.

ST Has marker -

INITIAL SITE SKETCH

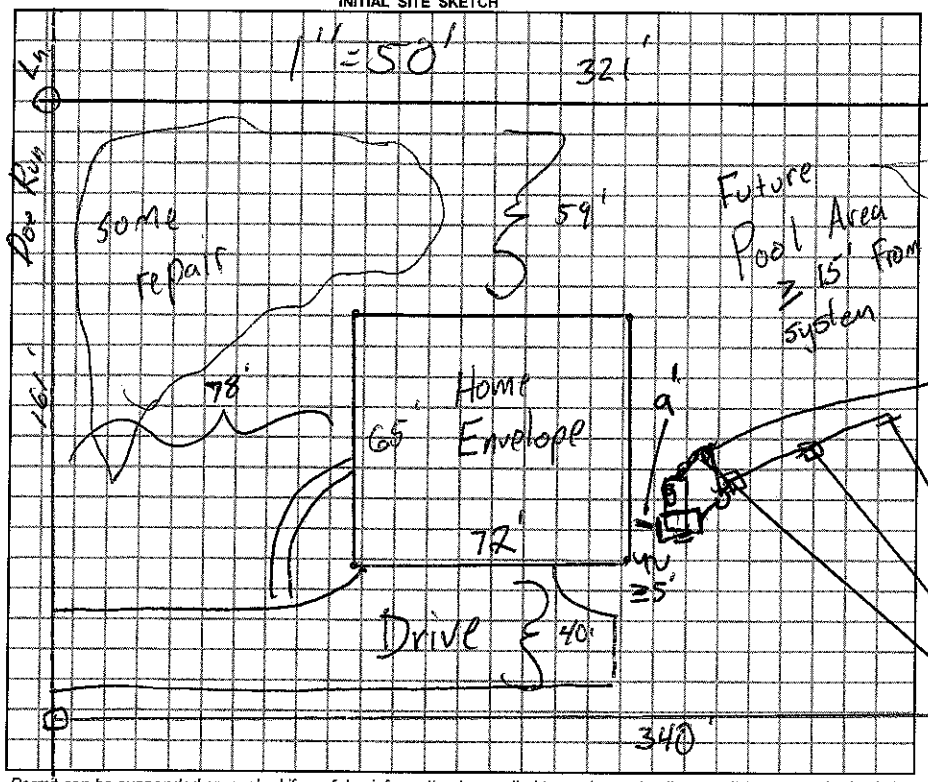

AS BUILT SKETCH

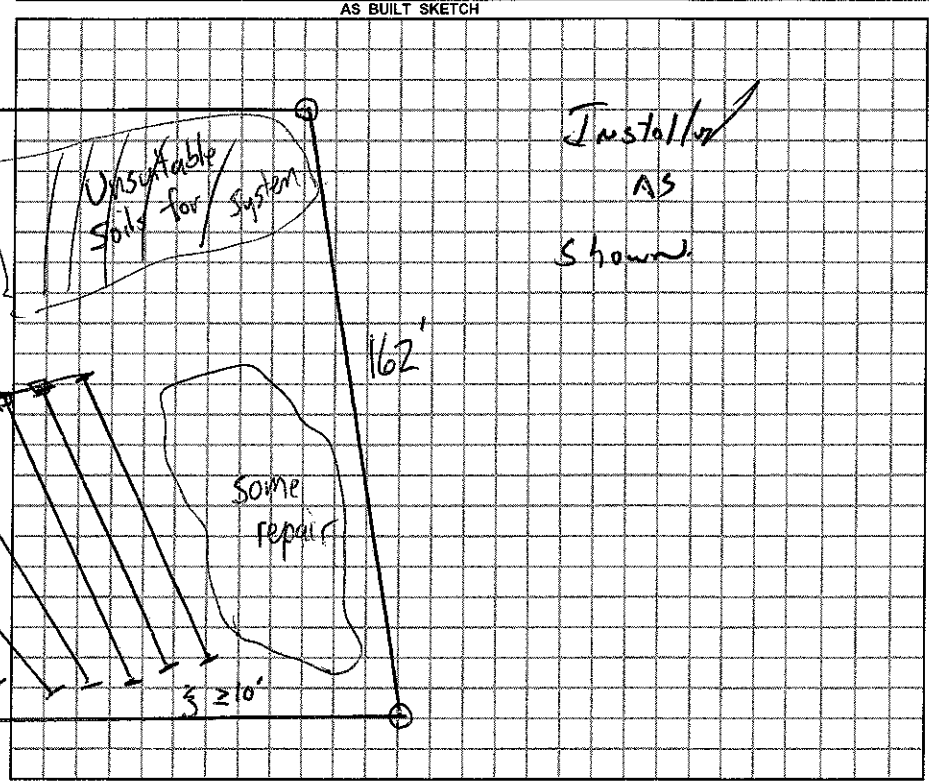

Permit can be suspended or revoked if any false information is supplied toward securing the permit / any unauthorized changes are made to the site / any unauthorized changes are made in the installation of the system.

☐ IMPROVEMENT PERMIT w / plat valid without expiration ☒ IMPROVEMENT PERMIT w / site plan valid for 60 mos ☐ AUTHORIZATION TO CONSTRUCT valid for period equal to IMPROVEMENT PERMIT-not to exceed 60 mo.

Owner / Applicant Signature: Date 6-24-10

Improvement Permit by: Date 6-14-10

Authorzation to Construct by: Date 8-19-10

Installed by: Leroy McSwain

Operation Permit by: , R. S. Date: 15 Feb 2011

Existing System Inspected by: Date:

YOU SHOULD CONTACT A LOCATOR SERVICE PRIOR TO ANY EXCAVATION.

WHITE COPY Environmental Health YELLOW COPY (Final) Owner / Applicant PINK COPY (Initial) Owner / Applicant