IREDELL COUNTY HEALTH DEPARTMENT

STATESVILLE 704-878-5305 MOORESVILLE 704-664-5281

* This permit replaces one issued 4-20-05 # 126798 DHT

(1) IMPROVEMENT PERMIT / AUTHORIZATION TO CONSTRUCT (2) OPERATION PERMIT (3) EXISTING SYSTEM INSPECTION

PERMIT # 16143 PIN # 4747473404 DATE 6-14-10

OWNER or APPLICANT Kevin Smith (Tom Palmer Home) PHONE: Business 980 241 9893 Home:

OWNER or APPLICANT ADDRESS 149 Doe Run Ln Statesville, NC

LOCATION / DIRECTIONS 21N; (L) Shumaker, continue onto White Farm Rd; (L) onto Doe Run Ln; last on (L)

SUBDIVISION Graystone Meadows BLOCK / SECTION LOT # 6 LOT AREA 1.274 DESIGN FLOW 480 L.T.A.R. .25

Septic Tank 1000 Gallons: STB 822 Date 11-12-10

Pump Tank Gallons: PT Date

Pump Make Model Serial #

Nitrification Field No Fields 1 No Lines 6 Linear Feet 480

Trench Width 36" Max. Trench Bottom Depth 36" Gravel Depth n/a

☒ New System ☐ Repair ☐ Expansion System Type I II (III) IV V VI

System Description: 25% Reduction Gravity

Repair System Description: 50% Reduction LPP

Maintenance Agreement Required ☐ YES ☒ NO

☒ GRAVITY ☐ PRESSURE

☒ Residence No. Bedrooms 4

☐ Business No. Persons

☐ Other No. Employees

☐ Slab ☒ Crawl Space

☐ Basement w/plumbing ☐ Basement w/o plumbing

Water Supply: ☐ Private ☒ Public ☐ Community


Comments / Conditions

Comments / Conditions


Poly Locate Fittings.

ST Has marker

INITIAL SITE SKETCH

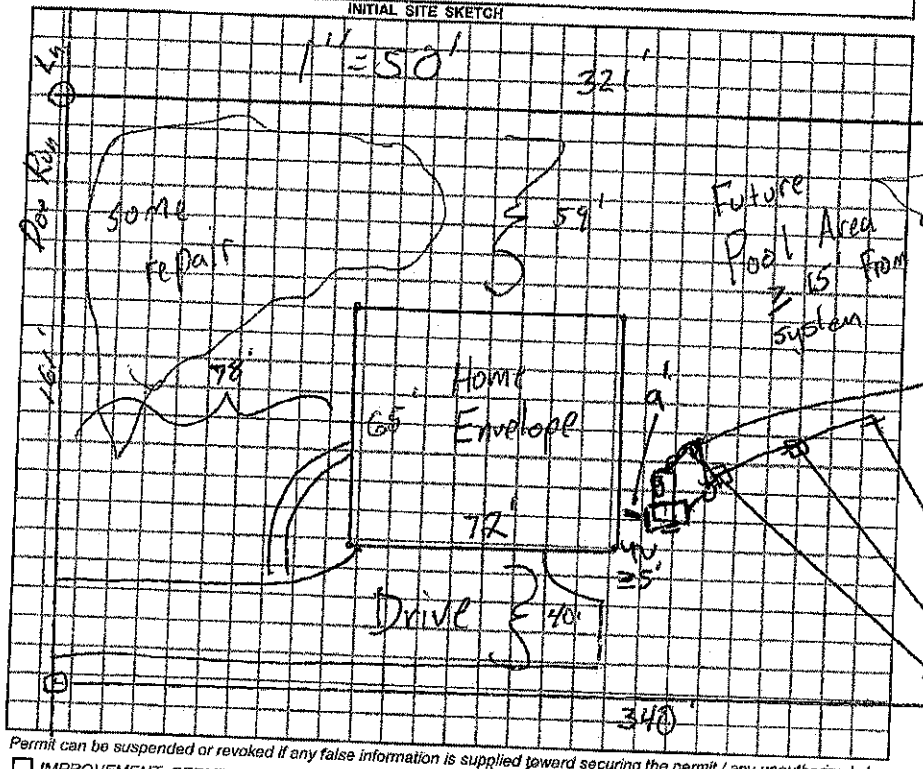

AS BUILT SKETCH

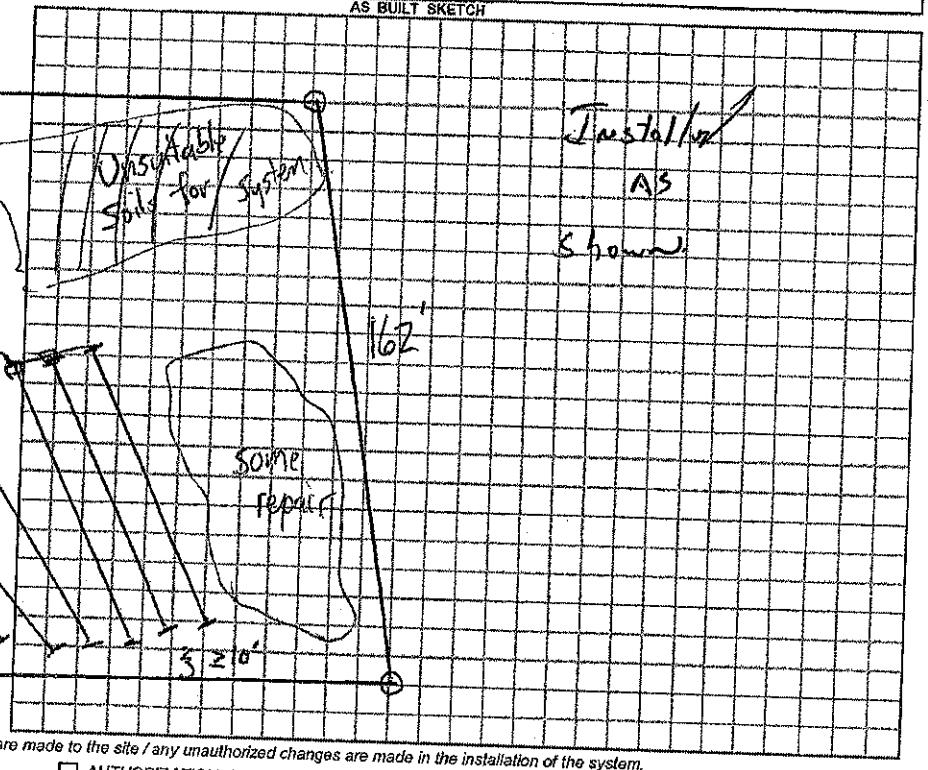

Permit can be suspended or revoked if any false information is supplied toward securing the permit / any unauthorized changes are made to the site / any unauthorized changes are made in the installation of the system.

☐ IMPROVEMENT PERMIT w / plat valid without expiration ☒ IMPROVEMENT PERMIT w / site plan valid for 60 mos ☐ AUTHORIZATION TO CONSTRUCT valid for period equal to IMPROVEMENT PERMIT-not to exceed 60 mo.

Owner / Applicant Signature: Date 6-24-10

Improvement Permit by: Date 6-14-10

Authorization to Construct by: Date 8-19-10

Installed by: Lenard McSwain

Operation Permit by: R. S. Date: 15 Feb 2011

Existing System Inspected by: Date:

YOU SHOULD CONTACT A LOCATOR SERVICE PRIOR TO ANY EXCAVATION.

WHITE COPY Environmental Health YELLOW COPY (Final) Owner / Applicant PINK COPY (Initial) Owner / Applicant