IREDELL COUNTY HEALTH DEPARTMENT

STATESVILLE 704-878-5305 (CI) MOORESVILLE 704-664-5281

IMPROVEMENT PERMIT / AUTHORIZATION TO CONSTRUCT / OPERATION PERMIT / EXISTING SYSTEM INSPECTION

PERMIT# 118/00 PIN# 4747-42-3884 DATE 3/25/04

OWNER OR CONTRACTOR DTN LLC PHONE: Business (704) 878-2517 Home

ADDRESS P.O. Box 5031 Statesville N.C. 28687

LOCATION Hwy 21 N. to Shumaker Rd to Chiles Farm Rd to Doe Run lot on Right

SUBDIVISION Gray Stone Manor BLOCK / SECTION — LOT 41 LOT AREA 1.0 SITE CLASS. F5 DESIGN FLOW 480 L.T.A.R. ~~.30~~ .25 gpd/ft

Septic Tank: 1000 Gallons; STB 1012 Date 10-2-05

Pump Tank: Gallons; PT Date

Pump Make: Model Serial No.

Nitrification Field: No Fields 1 Square Feet Equiv to Linear Feet 480

No Lines 6 @ 80' Trench Width 36" Max Trench Bottom Depth 30" Gravel Depth NA

☒ New System ☐ Repair System Type: I, II, III, IV, V, VI

System Description: Gravity, 25% Reduction

Repair System Description: Pump, 25% Reduction

Maintenance Agreement Required: ☐ Yes ☒ No

☒ House/Mod. Home No. Bedrooms 4

☐ Mobile Home No. Bathrooms 3

☐ Business No. Employees

☐ Other


☐ Slab ☒ Crawl Space ☐ Basement w/plumbing ☐ Basement wo/plumbing

Water Supply: ☐ Individual ☒ Public ☐ Community


Comments:/Conditions: ① Do not install when wet

Comments:/Conditions: Yellow filter
no risers ST marker

INITIAL SITE SKETCH

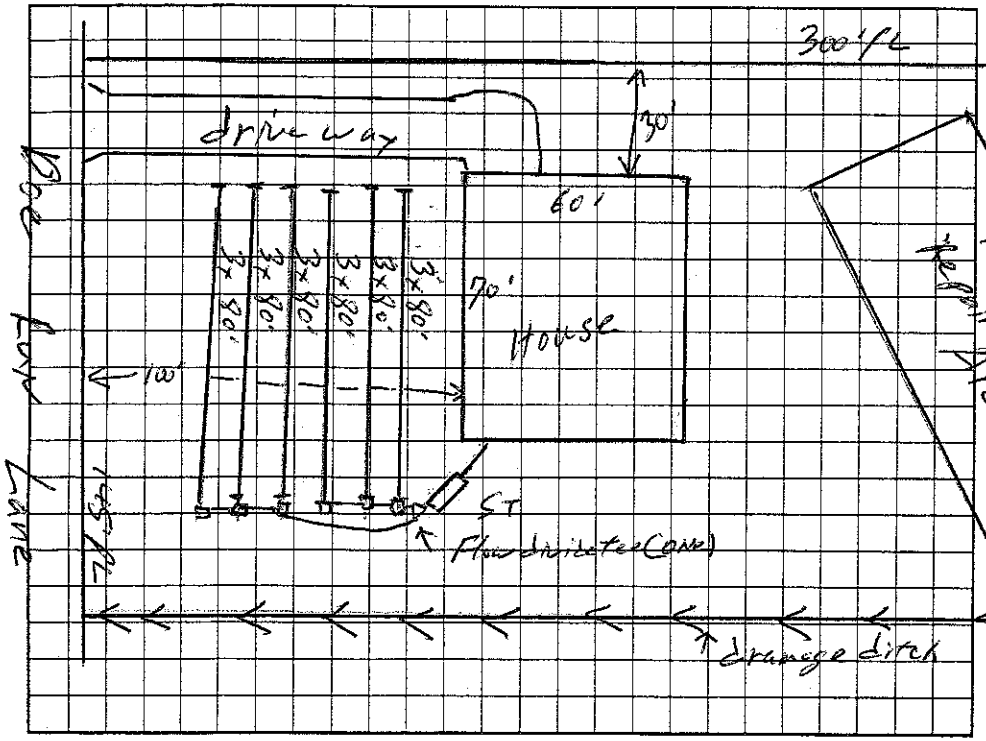

AS BUILT SKETCH

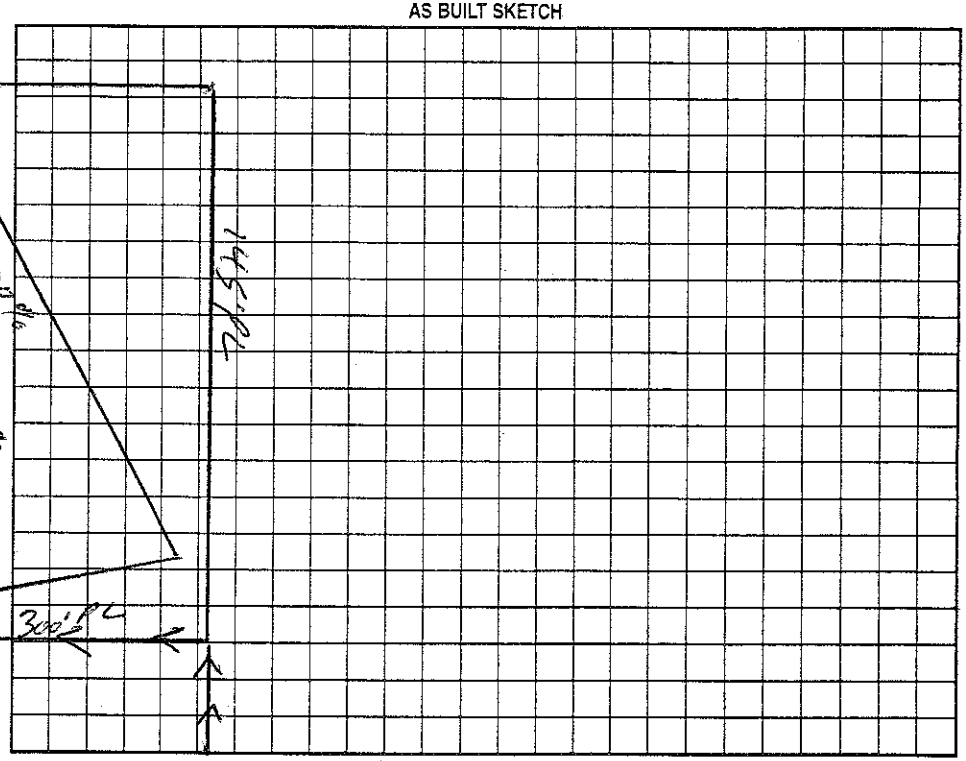

Permit can be suspended or revoked if any false information is supplied toward securing the permit/any unauthorized changes are made to the site/any unauthorized changes are made in the installation of the system. Improvement Permit with plat valid without expiration. Improvement Permit with site plan valid for sixty months. Authorization to Construct is valid for a period equal to that of Improvement Permit – not to exceed sixty months.

Signed: Sandra D. Marsden date 3/26/04 Installed by: David Yountz

Improvement Permit by: William A. Johnson date 3/25/04 Operation Permit by: JAMES date 5-11-06

Authorization to Construct by: STEVE REDRICK date 11-14-05 Existing System Inspection by: date

HEALTH DEPT. COPY: WHITE OWNER COPY (FINAL): YELLOW OWNER COPY (INITIAL): PINK