# IREDELL COUNTY HEALTH DEPARTMENT

STATESVILLE 704-878-5305 CJ MOORESVILLE 704-664-5281

## IMPROVEMENT PERMIT / AUTHORIZATION TO CONSTRUCT / OPERATION PERMIT / EXISTING SYSTEM INSPECTION

PERMIT# 11801 PIN# 4747-42-5824 DATE 2/29/04

OWNER OR CONTRACTOR K. W. Nicholson PHONE: Business (704) 878-2517 Home

ADDRESS 930 Argyle Ct. Statesville N.C. 28677

LOCATION Hwy 21 N, @ Shumaker Drive to White Farm Rd @ or Poe Run Lane (5th lot on Right)

SUBDIVISION Crystine Meadows BLOCK / SECTION — LOT 42 LOT AREA 1.0 Acres SITE CLASS. PT DESIGN FLOW 440 L.T.A.R. .25

Septic Tank: 1,000 Gallons; STB 1012 Date 4-5-04

Pump Tank: Gallons; PT Date

Pump Make: Model Serial No.

Nitrification Field: No Fields 1 Square Feet 64/920 Linear Feet 480

No Lines 5 Trench Width 36" Max Trench Bottom Depth 30" Gravel Depth NA

☒ New System ☐ Repair System Type: I, II, III, IV, V, VI

System Description: Gravity, 25% Reduction

Repair System Description: Low Profile Panel

Maintenance Agreement Required: ☐ Yes ☒ No

☒ House/Mod. Home No. Bedrooms 4

☐ Mobile Home No. Bathrooms 3

☐ Business No. Employees

☐ Other


☐ Slab ☒ Crawl Space ☐ Basement w/plumbing ☐ Basement wo/plumbing

Water Supply: ☐ Individual ☒ Public ☐ Community


Comments:/Conditions: ① Maintain proper setbacks ② do not install when wet ③ Install lines on contour

Comments:/Conditions: - Tuff-Tite filter + S.T. Marker Installed - E-Z-Flow Installed 1st Line 100 Ft, + 90 Ft 2nd line Installed 8/12/04, WJ.

INITIAL SITE SKETCH

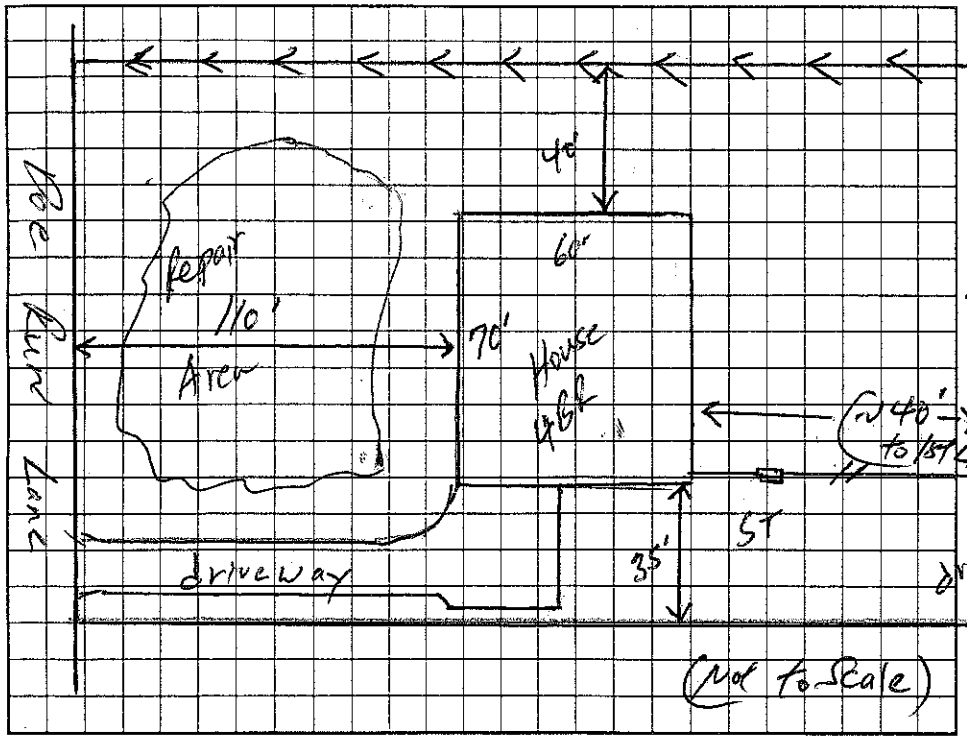


AS BUILT SKETCH

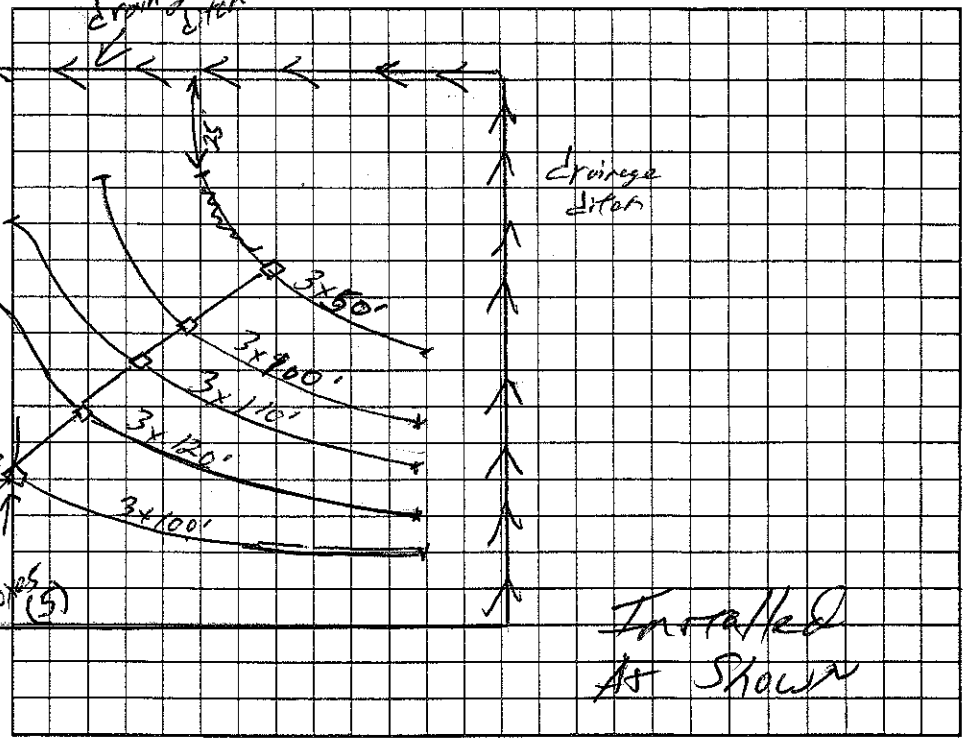


Permit can be suspended or revoked if any false information is supplied toward securing the permit/any unauthorized changes are made to the site/any unauthorized changes are made in the installation of the system. Improvement Permit with plat valid without expiration. Improvement Permit with site plan valid for sixty months. Authorization to Construct is valid for a period equal to that of Improvement Permit -- not to exceed sixty months.

Signed: K W N date Installed by: David Yountz

Improvement Permit by: William O. Johnson date 2/29/04 Operation Permit by: William O. Johnson date 8/17/04

Authorization to Construct by: William O. Johnson date 3/12/04 Existing System Inspection by: date

HEALTH DEPT. COPY: WHITE OWNER COPY (FINAL): YELLOW OWNER COPY (INITIAL): PINK