IREDELL COUNTY HEALTH DEPARTMENT

Statesville Office (704) 878-5305 Mooresville Office (704) 660-3625 PERMIT # 210819

IMPROVEMENT PERMIT / AUTHORIZATION TO CONSTRUCT / OPERATION PERMIT / EXISTING SYSTEM

PIN # 4747426863

APPLICANT: Isenhour Homes LLC APPLICANT ADDRESS: 3411 Healy Dr Winston Salem NC 27023

SITE ADDRESS: 130 Doe Run Ln Statesville NC PHONE: 336-345-1214 ALT. PHONE: 336-659-8211

SITE DIRECTIONS: 21N T/L Shumaker Dr T/L Doe Run Ln Lot 4th on right

SUBDIVISION: Graystone Meadow SECTION: 51 LOT # 43 LOT AREA: 1 ac DESIGN FLOW: 360 L.T.A.R.: 0.3


Septic Tank	1000	(gal)	STB	760	Date	7-19-15	[X] New System	[ ] Repair	[ ] Expansion	System Type: I II [III] IV V VI	
Pump Tank	N/A	(gal)	PT	N/A	Date	N/A	System Description:	25% Reduction			
Pump Make	N/A	Model	Dow/low		Serial #	PL-68	Repair System Description:	50% Reduction			
# Nitrification Fields	1	# Lines	3		Linear Ft:	300	Maintenance Agreement Required:	[ ] YES	[X] NO		
Trench Width	36"	Max. Trench Bottom Depth	36"		Gravel Depth	N/A		[X] GRAVITY	[ ] PRESSURE		

[X] Residence No. Bedrooms 3
[ ] Business No. Persons 6
[ ] Other No. Employees
[X] Slab [ ] Crawl Space
[ ] Basement w/plumbing [ ] Basement w/o plumbing


Water Supply: [ ] Private [X] Public [ ] Community

Comments / Conditions: Install 25% reduction on contour with serial distribution. *Minimum trench depth 36" on high side*

INITIAL SITE SKETCH

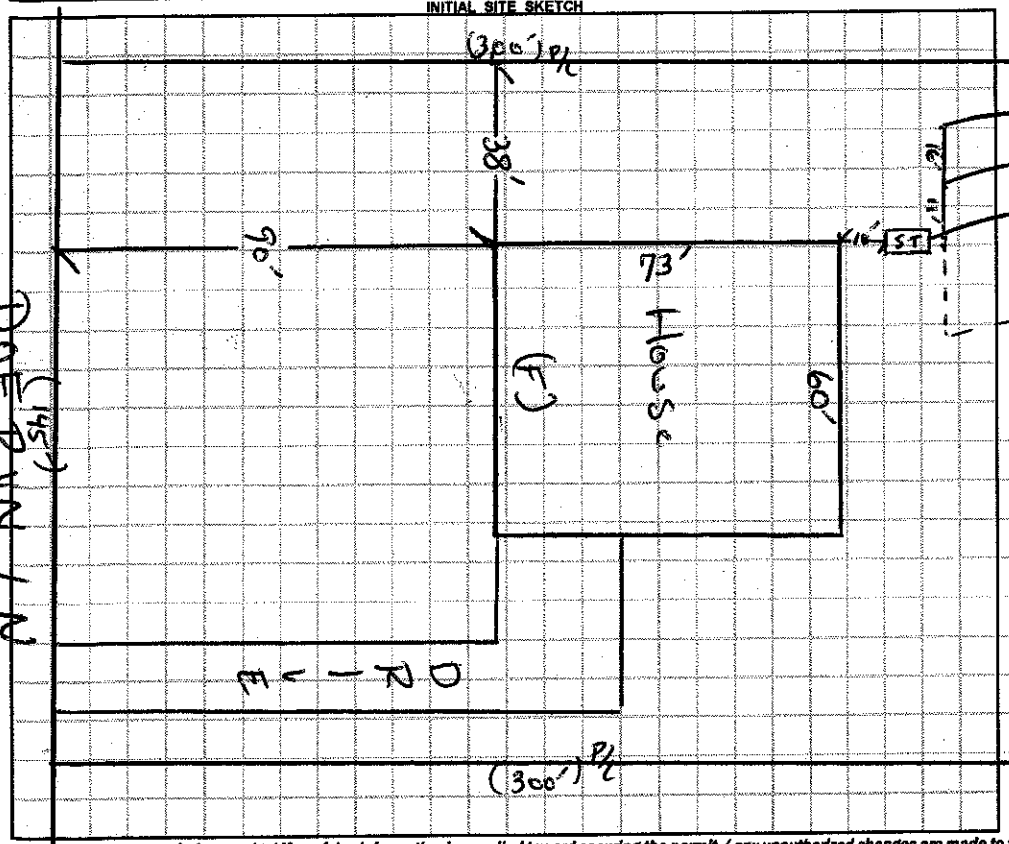

AS BUILT SKETCH

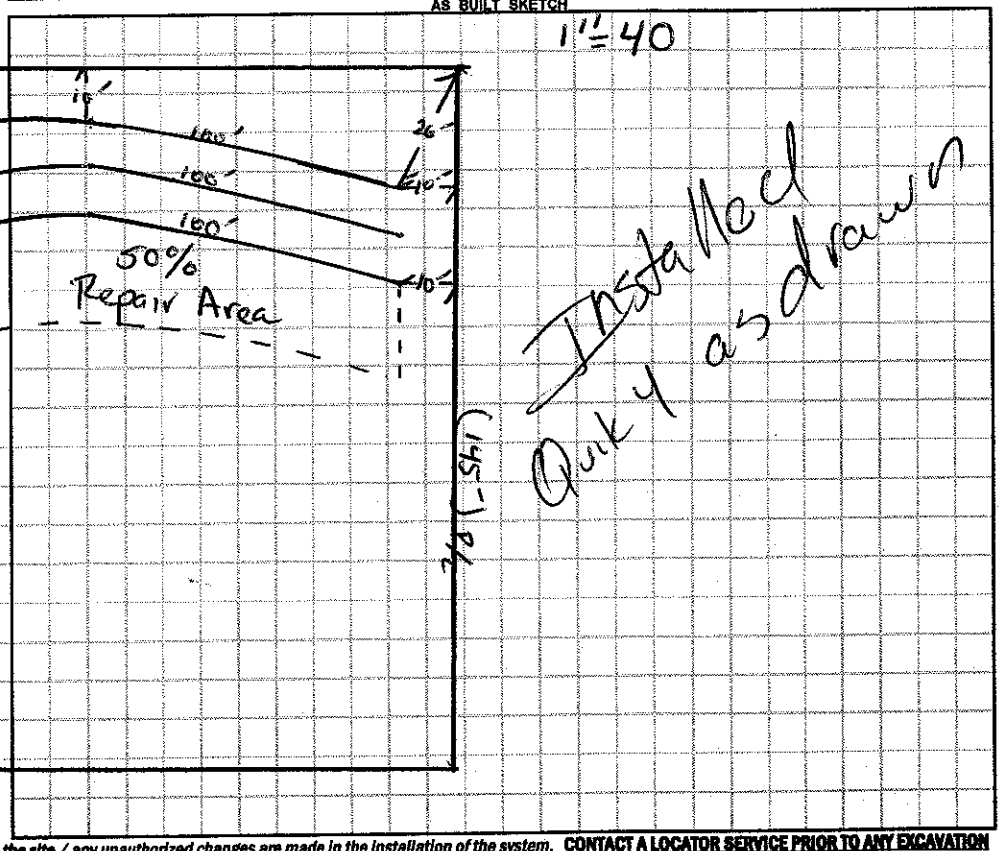

Permit can be suspended or revoked if any false information is supplied toward securing the permit / any unauthorized changes are made to the site / any unauthorized changes are made in the installation of the system. **CONTACT A LOCATOR SERVICE PRIOR TO ANY EXCAVATION**

[ ] **IMPROVEMENT PERMIT** *with plat valid without expiration.* [X] **IMPROVEMENT PERMIT** *with site plan valid for 60 mos.* [X] **AUTHORIZATION TO CONSTRUCT** *valid for period equal to IMPROVEMENT PERMIT--not to exceed 60 mo.*

Owner / Applicant Signature: Date: 6/17/15 Installed by: Frank Transou

IMPROVEMENT PERMIT by: Date: 06/15/15 OPERATION PERMIT by: Date: 11/23/15

AUTHORIZATION TO CONSTRUCT by: Date: 06/15/15 Existing System Inspected by: Date:

Health Dept. Copy - WHITE Applicant (Final Approval) - YELLOW Applicant (Conditional Approval) - PINK