IREDELL COUNTY HEALTH DEPARTMENT

STATESVILLE 704-878-5305 CI MOORESVILLE 704-664-5281

IMPROVEMENT PERMIT / AUTHORIZATION TO CONSTRUCT / OPERATION PERMIT / EXISTING SYSTEM INSPECTION

PERMIT# 114086 PIN# 4747-42-7540 DATE 9/5/03

OWNER OR CONTRACTOR Rick Wilson PHONE: Business (704) 902-2343 Home

ADDRESS 148 Beercroft Statesville, NC. 28625

LOCATION Hwy 21 N, @ Shoemaker Rd, turn into Winter Farm Rd, Left on Doe Run 3rd lot on Left

SUBDIVISION Gray Stone Meadows BLOCK / SECTION — LOT 3 LOT AREA 1.0 Acres SITE CLASS. P5 DESIGN FLOW 480 L.T.A.R. .30

Septic Tank: 4000 Gallons; STB 1012 Date 10-1-03
Pump Tank: ____ Gallons; PT ____ Date ____
Pump Make: ____ Model ____ Serial No. ____
Nitrification Field: No Fields 1 Square Feet 1600 Linear Feet 540
No Lines 6 Trench Width 36" Max Trench Bottom Depth 30" Gravel Depth 12"

☒ New System ☐ Repair System Type: I ☒ II, III, IV, V, VI
System Description: Gravity, Conventional
Repair System Description: LPP anels
Maintenance Agreement Required: ☐ Yes ☒ No


☒ House/Mod. Home ☐ Mobile Home ☐ Business ☐ Other
No. Bedrooms 4 No. Bathrooms 3 No. Employees ____
☐ Slab ☒ Crawl Space ☐ Basement w/plumbing ☐ Basement wo/plumbing

Water Supply: ☐ Individual ☒ Public ☐ Community

Comments/Conditions: ① Install lines on Contour with One(1) Flow divider tee and Five(5) drop boxes ② do not install when wet ③ maintain prop setbacks ④ Remove o/s Field Fence before installing septic system

Comments/Conditions: — Turf — Tire Filter + S.T Master Installed

INITIAL SITE SKETCH 1"=60'

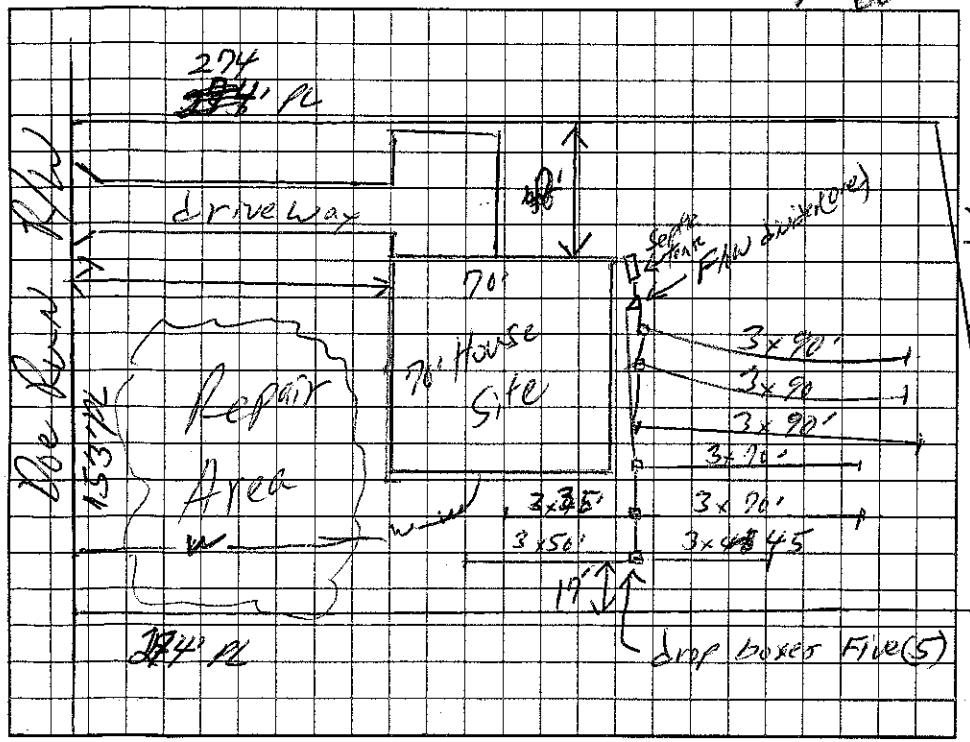

AS BUILT SKETCH

Installed As Shown Per Initial Site Sketch

Permit can be suspended or revoked if any false information is supplied toward securing the permit/any unauthorized changes are made to the site/any unauthorized changes are made in the installation of the system. Improvement Permit with plat valid without expiration. Improvement Permit with site plan valid for sixty months. Authorization to Construct is valid for a period equal to that of Improvement Permit – not to exceed sixty months.

Signed: Rick Wilson date 9/9/03
Improvement Permit by: William O. Johnson date 9/5/03
Authorization to Construct by: William O. Johnson date 9/5/03

Installed by: Steve Jordan (9/7/04)
Operation Permit by: William O. Johnson date 6/22/04
Existing System Inspection by: ____ date ____

HEALTH DEPT. COPY: WHITE OWNER COPY (FINAL): YELLOW OWNER COPY (INITIAL): PINK