IREDELL COUNTY HEALTH DEPARTMENT

STATESVILLE 704-878-5305 (CI) MOORESVILLE 704-664-5281

IMPROVEMENT PERMIT / AUTHORIZATION TO CONSTRUCT / OPERATION PERMIT / EXISTING SYSTEM INSPECTION

PERMIT# 11852 PIN# 4747-42-9500 DATE 2/12/04

OWNER OR CONTRACTOR Rob Wright PHONE: Business (704) 902-1443 Home —

ADDRESS 229 Tomlin Road Olin N.C. 28660

LOCATION Hwy 21 N to onto Shrewsbury Drive to White Farm Rd (1) Doe Run Rd (3rd lot on left)

SUBDIVISION Gray Stone Meadow BLOCK / SECTION — LOT 2 LOT AREA .97 Acre SITE CLASS. 5 DESIGN FLOW 360 L.T.A.R. .25 sp d/ft²

Septic Tank: 1,000 Gallons; STB 577 Date

Pump Tank: Gallons; PT Date

Pump Make: Model Serial No.

Nitrification Field: No Fields 1 Square Feet 440/440 Linear Feet 360

No Lines 4 Trench Width 36" Max Trench Bottom Depth 30" Gravel Depth N/A

☒ New System ☐ Repair System Type: I, II, (III), IV, V, VI

System Description: Gravity, 25% Reduction

Repair System Description: Pump, 25% Reduction

Maintenance Agreement Required: ☐ Yes ☐ No

☒ House/Mod. Home ☐ Mobile Home ☐ Business ☐ Other

No. Bedrooms 3 No. Bathrooms 2 No. Employees


☐ Slab ☒ Crawl Space ☐ Basement w/plumbing ☐ Basement wo/plumbing

Water Supply: ☐ Individual ☒ Public ☐ Community


Comments:/Conditions: SEE ATTACHED CHANGE TO FLOORPLAN

Comments:/Conditions: White Filter

INITIAL SITE SKETCH

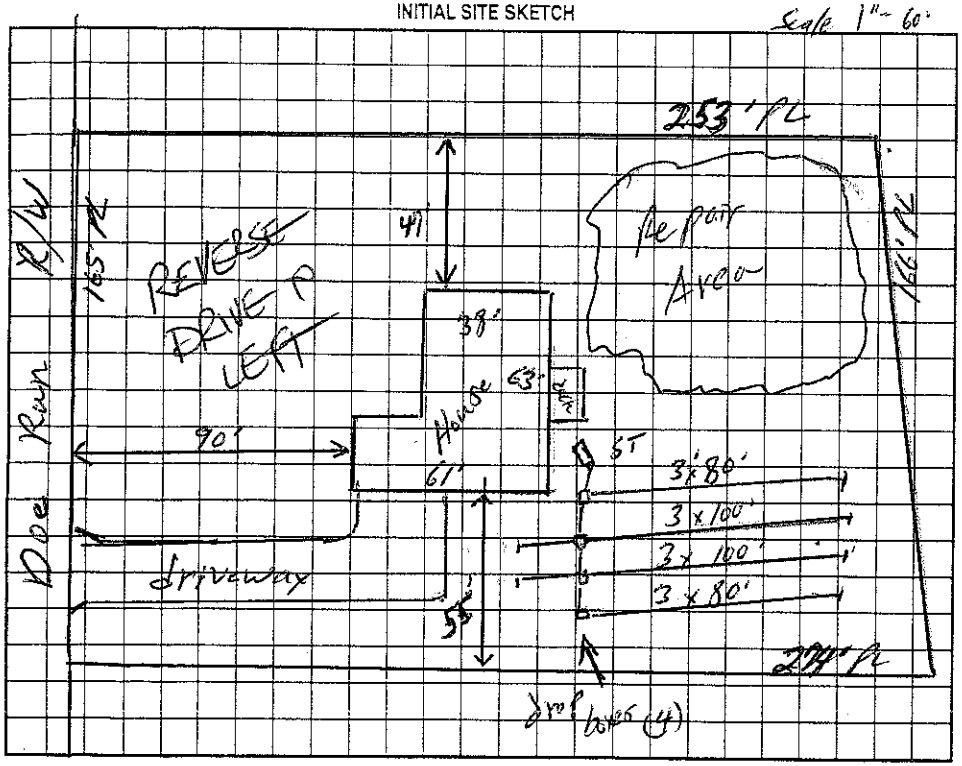

AS BUILT SKETCH

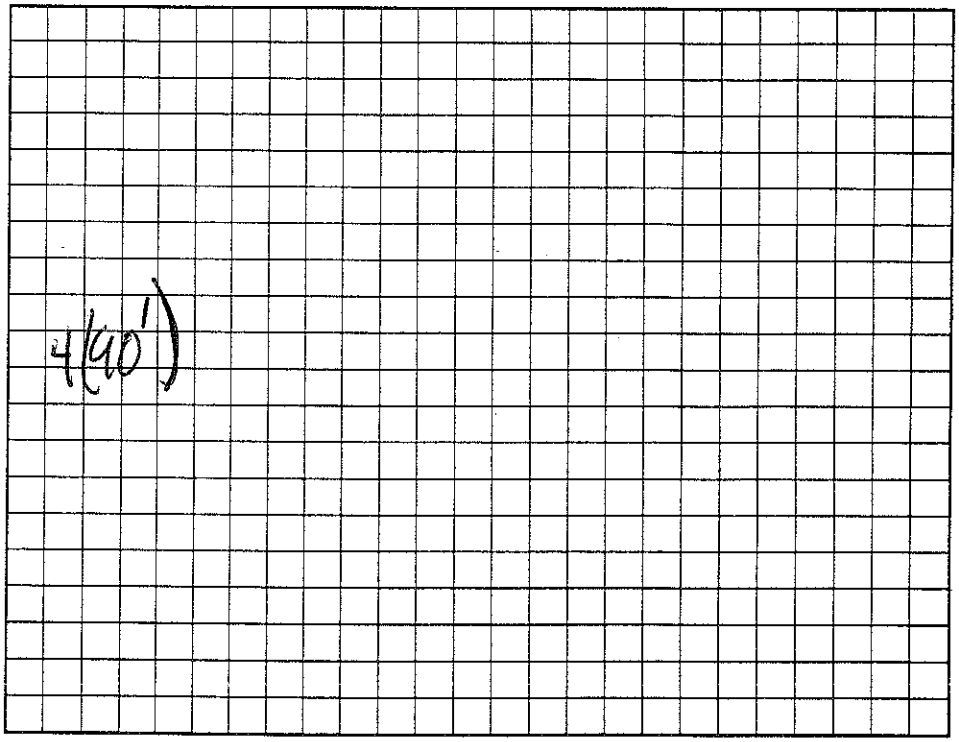

Permit can be suspended or revoked if any false information is supplied toward securing the permit/any unauthorized changes are made to the site/any unauthorized changes are made in the installation of the system. Improvement Permit with plat valid without expiration. Improvement Permit with site plan valid for sixty months. Authorization to Construct is valid for a period equal to that of Improvement Permit – not to exceed sixty months.

Signed: Joyce Wright date 2-17-04 Installed by: Tommy Faye

Improvement Permit by: William A. Johnson date 2/12/04 Operation Permit by: James Faye date 11/1/06

Authorization to Construct by: William A. Johnson date 2/12/04 Existing System Inspection by: date

HEALTH DEPT. COPY: WHITE OWNER COPY (FINAL): YELLOW OWNER COPY (INITIAL): PINK