IREDELL COUNTY HEALTH DEPARTMENT

STATESVILLE 704-878-5305 (CI) MOORESVILLE 704-664-5281

IMPROVEMENT PERMIT / AUTHORIZATION TO CONSTRUCT / OPERATION PERMIT / EXISTING SYSTEM INSPECTION

PERMIT# 132280 PIN# 4747433193 DATE 12-8-05

OWNER OR CONTRACTOR KW Nicholson Inc. PHONE: Business 704 878 2517 Home

ADDRESS Foxglove Dr. Statesville

LOCATION Hwy 21 N, (L) Shoemaker Dr., turns into Whites Farm Rd, property on left

SUBDIVISION Graystone Meadow BLOCK / SECTION LOT 32 LOT AREA .992 SITE CLASS. PS DESIGN FLOW L.T.A.R.

Septic Tank: 1000 Gallons; STB 1012 Date 10-2-05
Pump Tank: Gallons; PT Date
Pump Make: Model Serial No.
Nitrification Field: No Fields 1 Square Feet 1200 Linear Feet 400
No Lines 4 Trench Width 3 Max Trench Bottom Depth 36" Gravel Depth 12

☒ New System ☐ Repair System Type: I, II, III, IV, V, VI
System Description: Conventional Gravity
Repair System Description: 50% Reduction Pump
Maintenance Agreement Required: ☐ Yes ☒ No


☒ House/Mod. Home ☐ Mobile Home ☐ Business ☐ Other
No. Bedrooms 3 No. Bathrooms No. Employees
☐ Slab ☒ Crawl Space ☐ Basement w/plumbing ☐ Basement wo/plumbing

Water Supply: ☒ Individual ☐ Public ☐ Community


Comments:/Conditions:

Comments:/Conditions:

INITIAL SITE SKETCH

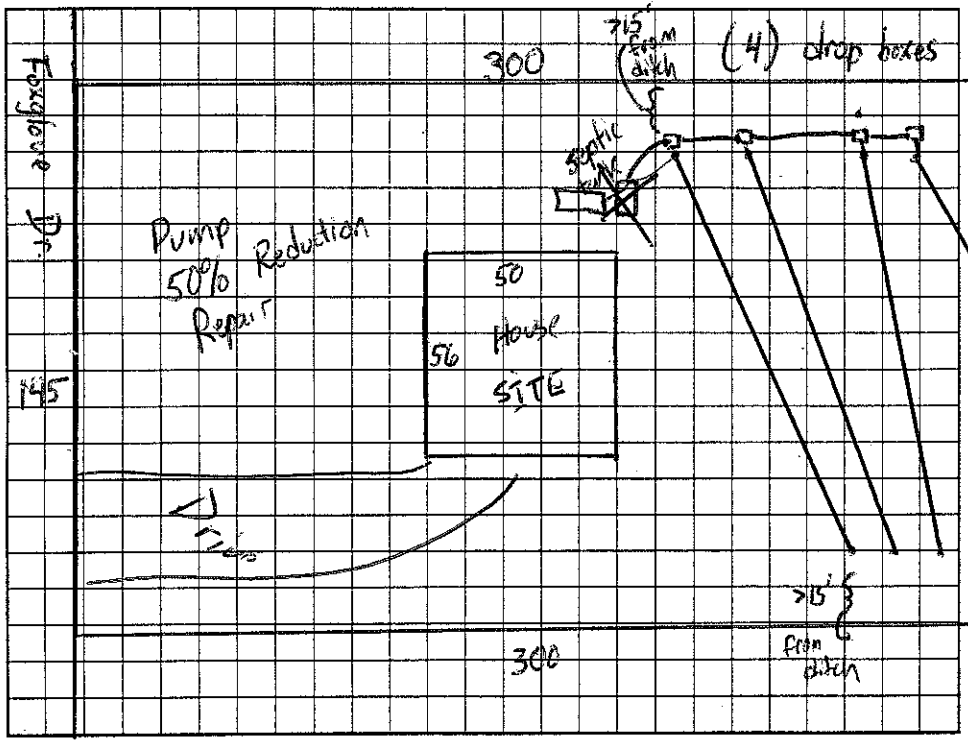

AS BUILT SKETCH

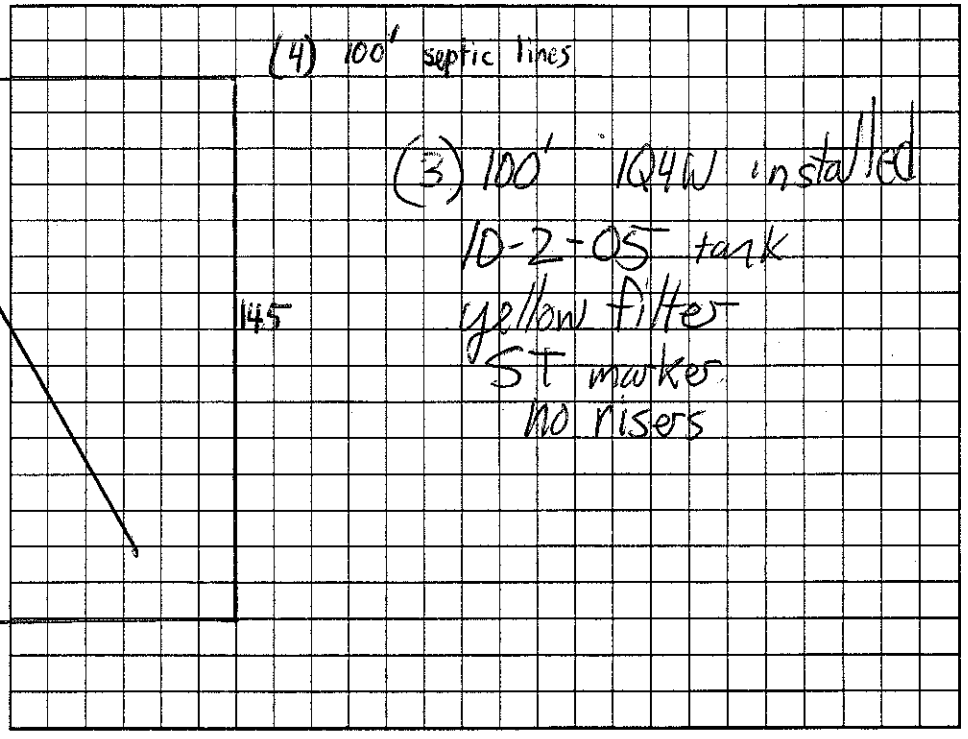

Permit can be suspended or revoked if any false information is supplied toward securing the permit/any unauthorized changes are made to the site/any unauthorized changes are made in the installation of the system. Improvement Permit with plat valid without expiration. Improvement Permit with site plan valid for sixty months. Authorization to Construct is valid for a period equal to that of Improvement Permit – not to exceed sixty months.

Signed: date 12-8-05 Installed by: David Yountz

Improvement Permit by: date Operation Permit by: date 5-12-06

Authorization to Construct by: date Existing System Inspection by: date

HEALTH DEPT. COPY: WHITE OWNER COPY (FINAL): YELLOW OWNER COPY (INITIAL): PINK