IREDELL COUNTY HEALTH DEPARTMENT

THIS PERMIT VOIDS PREVIOUS ISSUED 2-20-2004

STATESVILLE 704-878-5305 (C1) MOORESVILLE 704-664-5281

IMPROVEMENT PERMIT / AUTHORIZATION TO CONSTRUCT / OPERATION PERMIT / EXISTING SYSTEM INSPECTION

PERMIT# 118098 PIN# 4747-43-6172 DATE 7-1-05

OWNER OR CONTRACTOR K. W. NICHOLSON INC. PHONE: Business 704-902-0799 Home

ADDRESS 930 ARGYLE COURT, STATESVILLE NC 28627

LOCATION US 21 N, TL JENNINGS RD, TL WHITES FARM RD, TR FOX GLOVE DR LOT #30 ON LEFT

SUBDIVISION GRAYSTONE MEADOWS BLOCK / SECTION I LOT 30 LOT AREA 1.0 ACRE SITE CLASS. PS DESIGN FLOW 480 L.T.A.R. 0.30 GPD/FT²

Septic Tank: 1000 Gallons; STB 1012 Date 1-16-05

Pump Tank: Gallons; PT Date

Pump Make: Model Serial No.

Nitrification Field: No. Fields 1 Square Feet ~~1600~~ 1600 Linear Feet ~~400~~

No Lines SIX Trench Width 36" Max Trench Bottom Depth (30") Gravel Depth N/A

☑ New System ☐ Repair System Type: I, II, III, IV, V, VI

System Description: 25% REDUCTION, GRAVITY

Repair System Description: 50% REDUCTION LOW PRESSURE

Maintenance Agreement Required: ☐ Yes ☑ No

☑ House/Mod. Home No. Bedrooms 4

☐ Mobile Home No. Bathrooms

☐ Business No. Employees

☐ Other


☐ Slab ☑ Crawl Space ☐ Basement w/plumbing ☐ Basement wo/plumbing

Water Supply: ☐ Individual ☑ Public ☐ Community


Comments:/Conditions: (1) INSTALL 25% REDUCTION SYSTEM ON CONTOUR NO DEEPER THAN 30" (2) DIVERT SURFACE WATER AWAY FROM DRAINFIELD

Comments:/Conditions: SEPTIC TANK WITH MARKER INSTALLED USING "TUFTITE" FILTER

INITIAL SITE SKETCH SCALE: 1"=50'

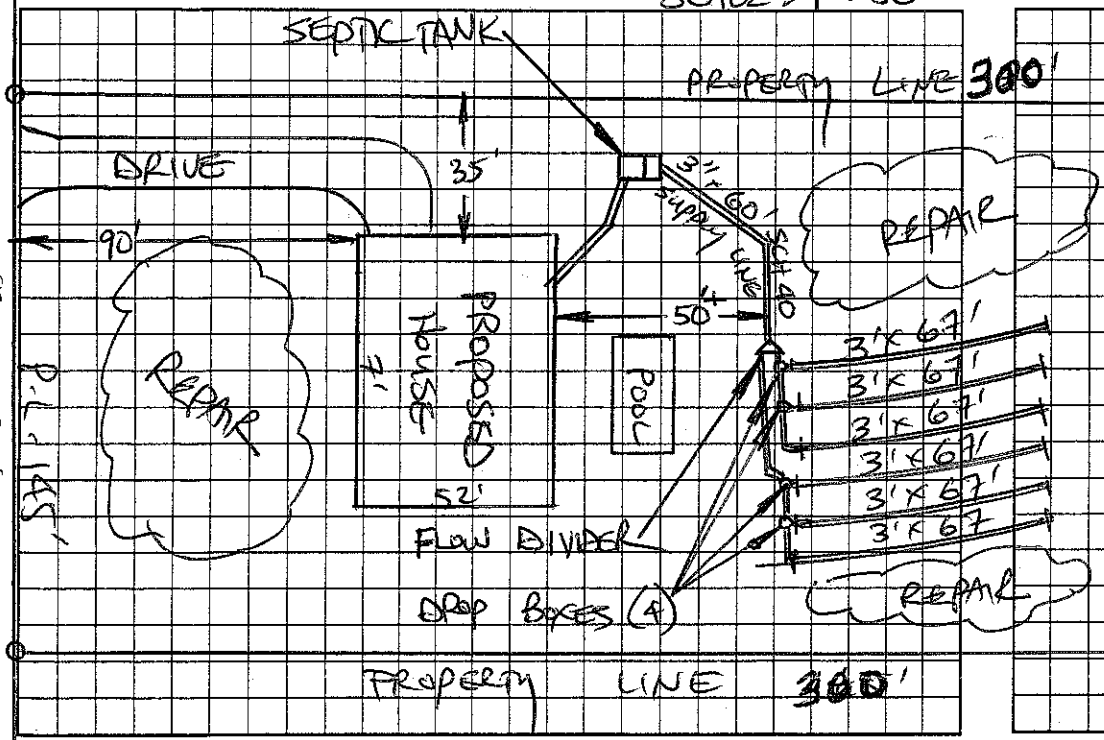

AS BUILT SKETCH

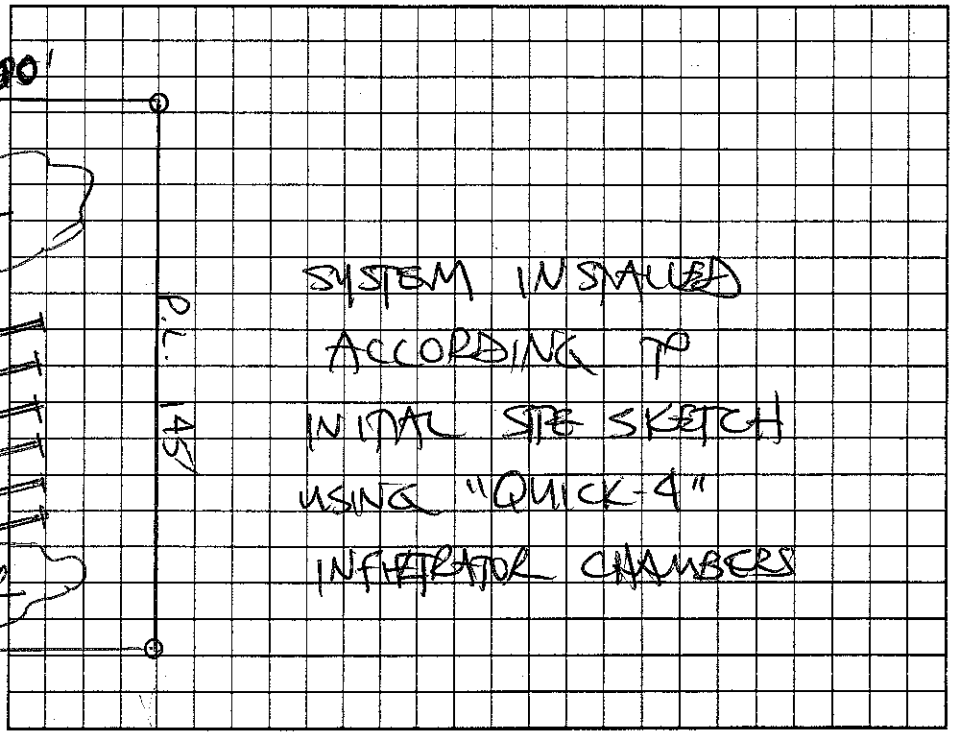

Permit can be suspended or revoked if any false information is supplied toward securing the permit/any unauthorized changes are made to the site/any unauthorized changes are made in the installation of the system. Improvement Permit with plat valid without expiration. Improvement Permit with site plan valid for sixty months. Authorization to Construct is valid for a period equal to that of Improvement Permit – not to exceed sixty months.

Signed: [signature] date 7-1-05

Improvement Permit by: STEVE HEDRICK date 7-1-05

Authorization to Construct by: STEVE HEDRICK date 7-1-05

Installed by: DAVID YOUNTZ

Operation Permit by: STEVE HEDRICK date 7-8-05

Existing System Inspection by: date

HEALTH DEPT. COPY: WHITE OWNER COPY (FINAL): YELLOW OWNER COPY (INITIAL): PINK