IREDELL COUNTY HEALTH DEPARTMENT

STATESVILLE 704-878-5305 CI MOORESVILLE 704-664-5281

IMPROVEMENT PERMIT / AUTHORIZATION TO CONSTRUCT / OPERATION PERMIT / EXISTING SYSTEM INSPECTION

PERMIT# 118092 PIN# 4747-43-8122 DATE 2/20/04

OWNER OR CONTRACTOR Chris Davidson PHONE: Business (704) 363-2634 Home

ADDRESS P.O. Box 5602 Statesville NC 28687

LOCATION Hwy 21 N (R) Shumaker Drive to Whites Farm Rd (L) on Foxglove Drive

SUBDIVISION Stone Meadow BLOCK / SECTION - LOT 29 LOT AREA 1.0 Acre SITE CLASS. PS DESIGN FLOW 480 L.T.A.R. .30 EAM 2

Septic Tank: 4000 Gallons; STB 1012 Date 9-19-06

Pump Tank: Gallons; PT Date

Pump Make: Model Serial No.

Nitrification Field: No Fields 1 Square Feet 4600 Linear Feet 535

No Lines 5 Trench Width 36" Max Trench Bottom Depth 30" Gravel Depth 12"

☒ New System ☐ Repair System Type: I (II) III, IV, V, VI

System Description: Gravity Conventional

Repair System Description: Gravity 25% Reduction

Maintenance Agreement Required: ☐ Yes ☒ No

☒ House/Mod. Home ☐ Mobile Home ☐ Business ☐ Other

No. Bedrooms 4 No. Bathrooms 3 No. Employees


Water Supply: ☐ Individual ☒ Public ☐ Community

☐ Slab ☒ Crawl Space ☐ Basement w/plumbing ☐ Basement wo/plumbing


Comments:/Conditions: @ maintain proper setbacks

Comments:/Conditions: Yellow Flags ST marker

INITIAL SITE SKETCH

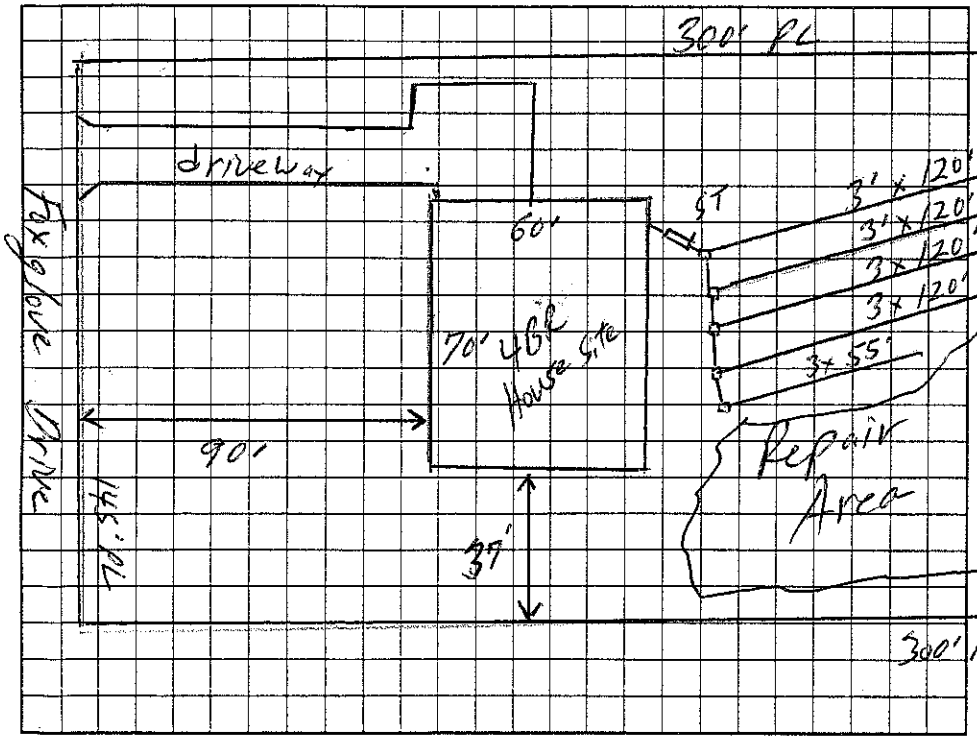

AS BUILT SKETCH

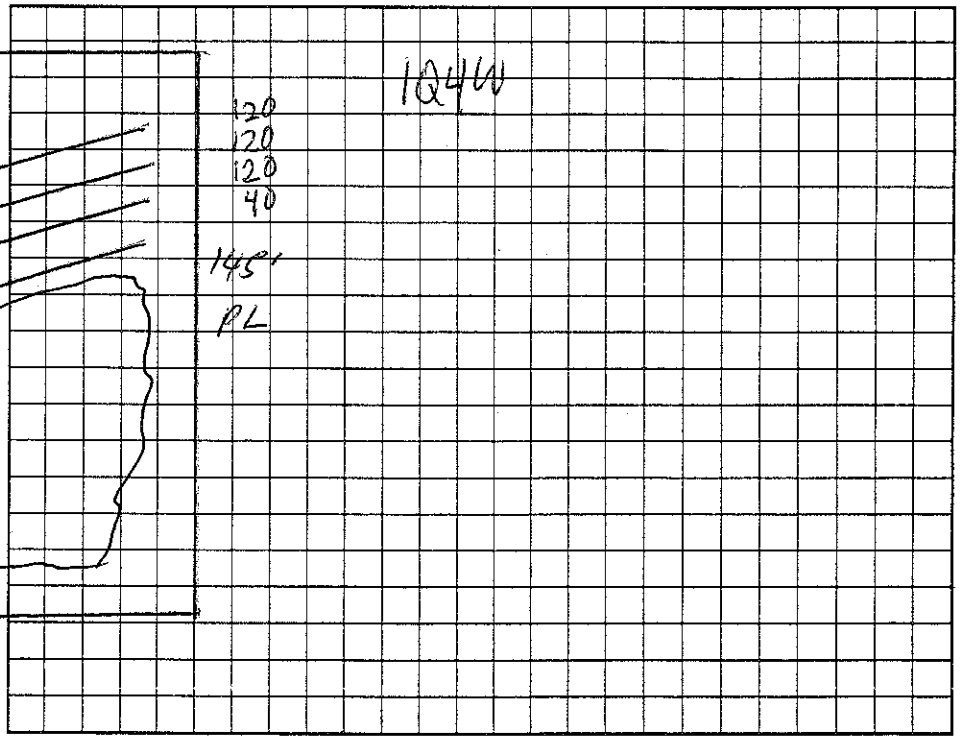

Permit can be suspended or revoked if any false information is supplied toward securing the permit/any unauthorized changes are made to the site/any unauthorized changes are made in the installation of the system. Improvement Permit with plat valid without expiration. Improvement Permit with site plan valid for sixty months. Authorization to Construct is valid for a period equal to that of Improvement Permit – not to exceed sixty months.

Signed: date

Installed by: David Younts

X Improvement Permit by: date 2/20/04

Operation Permit by: date 4-4-07

Authorization to Construct by: date 7-7-06

Existing System Inspection by: date

HEALTH DEPT. COPY: WHITE OWNER COPY (FINAL): YELLOW OWNER COPY (INITIAL): PINK