call 12:0

IREDELL COUNTY HEALTH DEPARTMENT

STATESVILLE 704-878-5305 MOORESVILLE 704-664-5281

IMPROVEMENT PERMIT / AUTHORIZATION TO CONSTRUCT / OPERATION PERMIT / EXISTING SYSTEM INSPECTION

PERMIT# 144486 PIN# 4747438412 DATE 8-22-07

OWNER OR APPLICANT R.W Wright Construction & Contracting PHONE: Business 704 876-6906 Home

ADDRESS Foxglove Drive

LOCATION Whites Farm Rd to Left on Foxglove, property on right

SUBDIVISION Greystone BLOCK / SECTION LOT 26 LOT AREA 1 SITE CLASS PS DESIGN FLOW 360 L.T.A.R. .3

Septic Tank: 1000 Gallons: STB 1012 Date 5-15-07

Pump Tank: Gallons: PT Date

Pump Make: Model Serial No

Nitrification Field: No Fields 1 Square Feet 1600 Linear Feet 400

No Lines 3 Trench Width 36" Max Trench Bottom Depth 36" Gravel Depth Gravity ☐ Pressure

☒ New System ☐ Repair ☐ Expansion System Type: I II III IV V VI

System Description: 25% Reduction

Repair System Description: 25% Reduction (Pump Fnc)

Maintenance Agreement Required: ☐ Yes ☒ No

☒ House/Mod. Home ☐ Mobile Home ☐ Business ☐ Other

No. Bedrooms 4 No. Persons No. Employees


Water Supply: ☒ Individual ☐ Public ☐ Community

☐ Slab ☐ Crawl Space ☐ Basement w/plumbing ☒ Basement wo/plumbing

Comments/Conditions: 214

(3) × 133' × 3' split fed

INITIAL SITE SKETCH

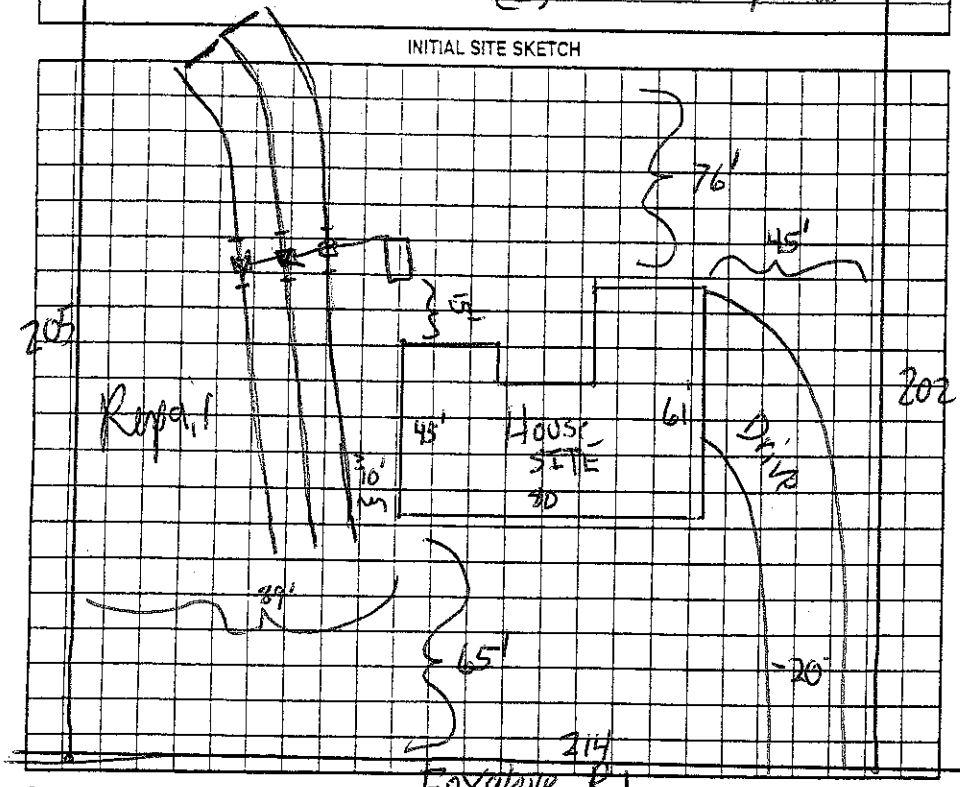

Comments/Conditions: Yellow filter

AS BUILT SKETCH

Permit can be suspended or revoked if any false information is supplied toward securing the permit/any unauthorized changes are made to the site/any unauthorized changes are made in the installation of the system. Improvement Permit with plat valid without expiration ☐ Improvement Permit with site plan valid for sixty months ☒ Authorization to Construct is valid for a period equal to that of Improvement Permit – not to exceed sixty months.

Signed: Rob Wright date 8-23-07

Improvement Permit by: James date 8-22-07

Authorization to Construct by: James date 8-22-07

Installed by: Tommy Frye

Operation Permit by: James date 1-9-08

Existing System Inspection by: date

HEALTH DEPT. COPY: WHITE OWNER COPY (FINAL): YELLOW OWNER COPY (INITIAL): PINK