IREDELL COUNTY HEALTH DEPARTMENT

STATESVILLE 704-878-5305 MOORESVILLE 704-664-5281

IMPROVEMENT PERMIT / CERTIFICATE OF COMPLETION / OPERATION PERMIT / EXISTING SYSTEM INSPECTION

PROPERTY DESCRIPTION NO. 24999 / DATE 1-7-97 TAX MAP NO. 106 - A-19

OWNER OR CONTRACTOR Pamela Taylor PHONE: Business Home 876-9093 Watershed: ☑ Yes ☐ No

ADDRESS 841 Whites Fm Rd

LOCATION 21N TL Shoemaker to Whites Fm Rd TL Dietz Rd 1/8 mi Rt back out infill

SUBDIVISION BLOCK / SECTION LOT LOT AREA 2acre± SITE CLASS. PS DESIGN FLOW 360 L.T.A.R. .33

Septic Tank: 1000 Gallons; STB 1012 Date 8-29-97

Pump Tank: Gallons; PT Date

Pump Make: Model Serial No.

Nitrification Field: No Fields 1 Square Feet 1080 Linear Feet 360

No Lines 3 Trench Width 36" Max Trench Bottom Depth 36" Gravel Depth 12"

☑ New System ☐ Repair System Type: I, II, III, IV, V, VI

System Description: Conv. Gravity

Repair System Description:

Maintenance Agreement Required: ☐ Yes ☐ No

☐ House/Mod. Home No. Bedrooms 3

☑ Mobile Home No. Bathrooms 2

☐ Business No. Employees


☐ Other

☐ Slab ☑ Crawl Space ☐ Basement w/plumbing ☐ Basement wo/plumbing

Water Supply: ☐ Individual ☐ Community ☑ Public

Comments:

INITIAL SITE SKETCH

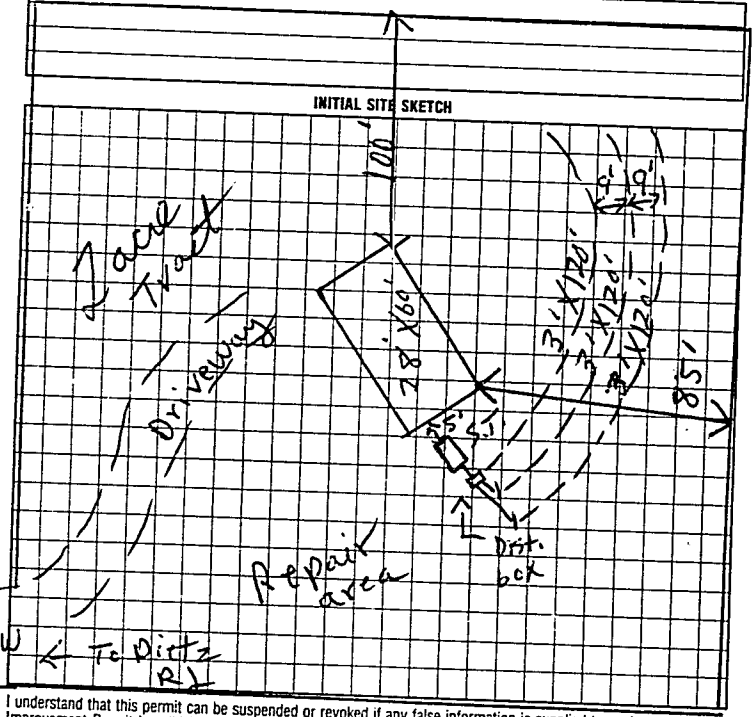

Comments:

AS BUILT SKETCH

Installed as shown

I understand that this permit can be suspended or revoked if any false information is supplied toward securing the permit/any unauthorized changes are made to the site/any unauthorized changes are made in the installation of the system. Improvement Permit is valid for 60 months from date of issuance.

Signed: X Jan M. Frye

Improvement Permit by: L.C. Moore date 1-7-97

Authorization to Const.

Existing System Inspection by: L.C. Moore date 1-7-97

Authorization to Const.

Installed by: Tommy Frye

Certificate of Completion by: date

Operation Permit by: Mark Cox RS date 10-10-97

EXPIRES 60 MOS FROM ISSUE

HEALTH DEPT COPY WHITE INSPECTION COPY (FINAL) GREEN OWNER COPY (FINAL) YELLOW INSPECTION COPY (INITIAL) PINK OWNER COPY (INITIAL) BLUE

L 96200