ICHD - ENVIRONMENTAL HEALTH DIVISION

BCW

Statesville Office (704) 878-5305 Mooresville Office (704) 660-3625 PERMIT # 2023-35267

SEPTIC: IMPROVEMENT PERMIT / AUTHORIZATION TO CONSTRUCT / OPERATION PERMIT / EXISTING SYSTEM Repair PIN # 4747 -- 47 -- 9535

APPLICANT/OWNER: Carolyn & Rex Mchaffey APPLICANT ADDRESS: 118 Deitz Rd, Statesville

SITE ADDRESS: 118 Deitz Rd, Statesville 28625 PHONE: 704-876-3834 ALT. PHONE

SITE DIRECTIONS: Jennings - Whites Farm - Deitz SAP CONTROLLED: ☐ YES ☐ NO


SUBDIVISION: - SECTION: -- LOT # -- LOT AREA: 7.57 acres DESIGN FLOW: EX L.T.A.R.: EX

Septic Tank	1000	(gal)	STB		Date		☐ New System	☒ Repair	☐ Expansion	System Type: I (II) III IV V VI	
Pump Tank		(gal)	PT		Date		System Description:	Tank Replacement			
Pump Make		Model			Serial #		Repair System Description:	EXISTING			
# Nitrification Fields	EX	# Lines	EX		Linear Ft	EX	Maintenance Agreement Required:	☐ YES	☒ NO		
Trench Width	EX	Trench Bottom Depth(Low side)		EX	Gravel Depth	EX		☐ GRAVITY	☒ PRESSURE		

☒ Residence	No. Bedrooms	EX	**Water Supply**
☐ Business	No. Persons	EX	☐ Private
☐ Other	No. Employees		☒ Public
☐ Slab	☒ Crawl Space		☐ Community
☐ Basement w/plumbing	☐ Basement w/o plumbing		

Comments / Conditions: Pump, crush, & fill old septic tank. Replace distribution if necessary.

INITIAL SITE SKETCH

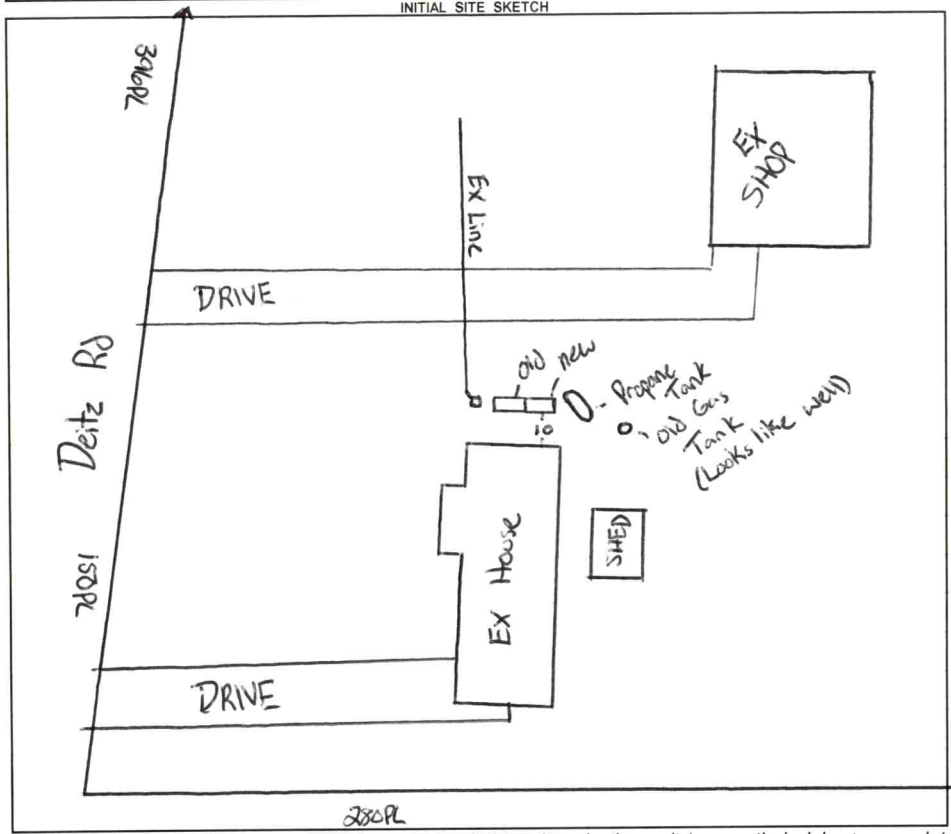

AS BUILT SKETCH

FOR SEPTIC FINAL INSPECTION CALL: 704-664-3703 between 8am-9am the day the inspection is needed. Be sure to speak with an inspector to confirm your time.

Lots combined BK 3021 PG 1109-1112

Installed as Shown

388'PL

Permit can be suspended or revoked if any false information is supplied toward securing the permit / any unauthorized changes are made to the site / any unauthorized changes are made in the installation of the system. **CONTACT A LOCATOR SERVICE PRIOR TO ANY EXCAVATION**

☐ **IMPROVEMENT PERMIT** ***with plat*** *valid without expiration.* ☒ **IMPROVEMENT PERMIT** ***with site plan*** *valid for 60 mos.* ☒ **AUTHORIZATION TO CONSTRUCT** *valid for period equal to IMPROVEMENT PERMIT--not to exceed 60 mo.*

Owner / Applicant Signature: Online Signature Date: Installed by: Lentz


IMPROVEMENT PERMIT by: Cary Hil Date: 10/12/23 OPERATION PERMIT by: Sydney Howard Date: 10/17/23

AUTHORIZATION TO CONSTRUCT by: Cary Hil Date: 10/12/23 Existing System Inspected by: Date:

FOR SEPTIC FINAL INSPECTION: CALL 704-664-3703 between 8am-9am the day the inspection is needed.

Item	Date	Initials
Drain Lines Checked		
Tanks Checked		
Pressure Manifold or Valve Box Checked		
Pressure Head Set		
Electrical Checked		
Floats Set		
Alarm Checked		
Maintenance Contract Needed? Y / N		
Comments:		

Repairs Only	
	State Code
Failing System Code	
Type of Distribution	G or P
Type of Failure/Malfunction	
Primary Cause of Failure/Malfunction	
Age of System? _____	
Initial or Repair? _____	

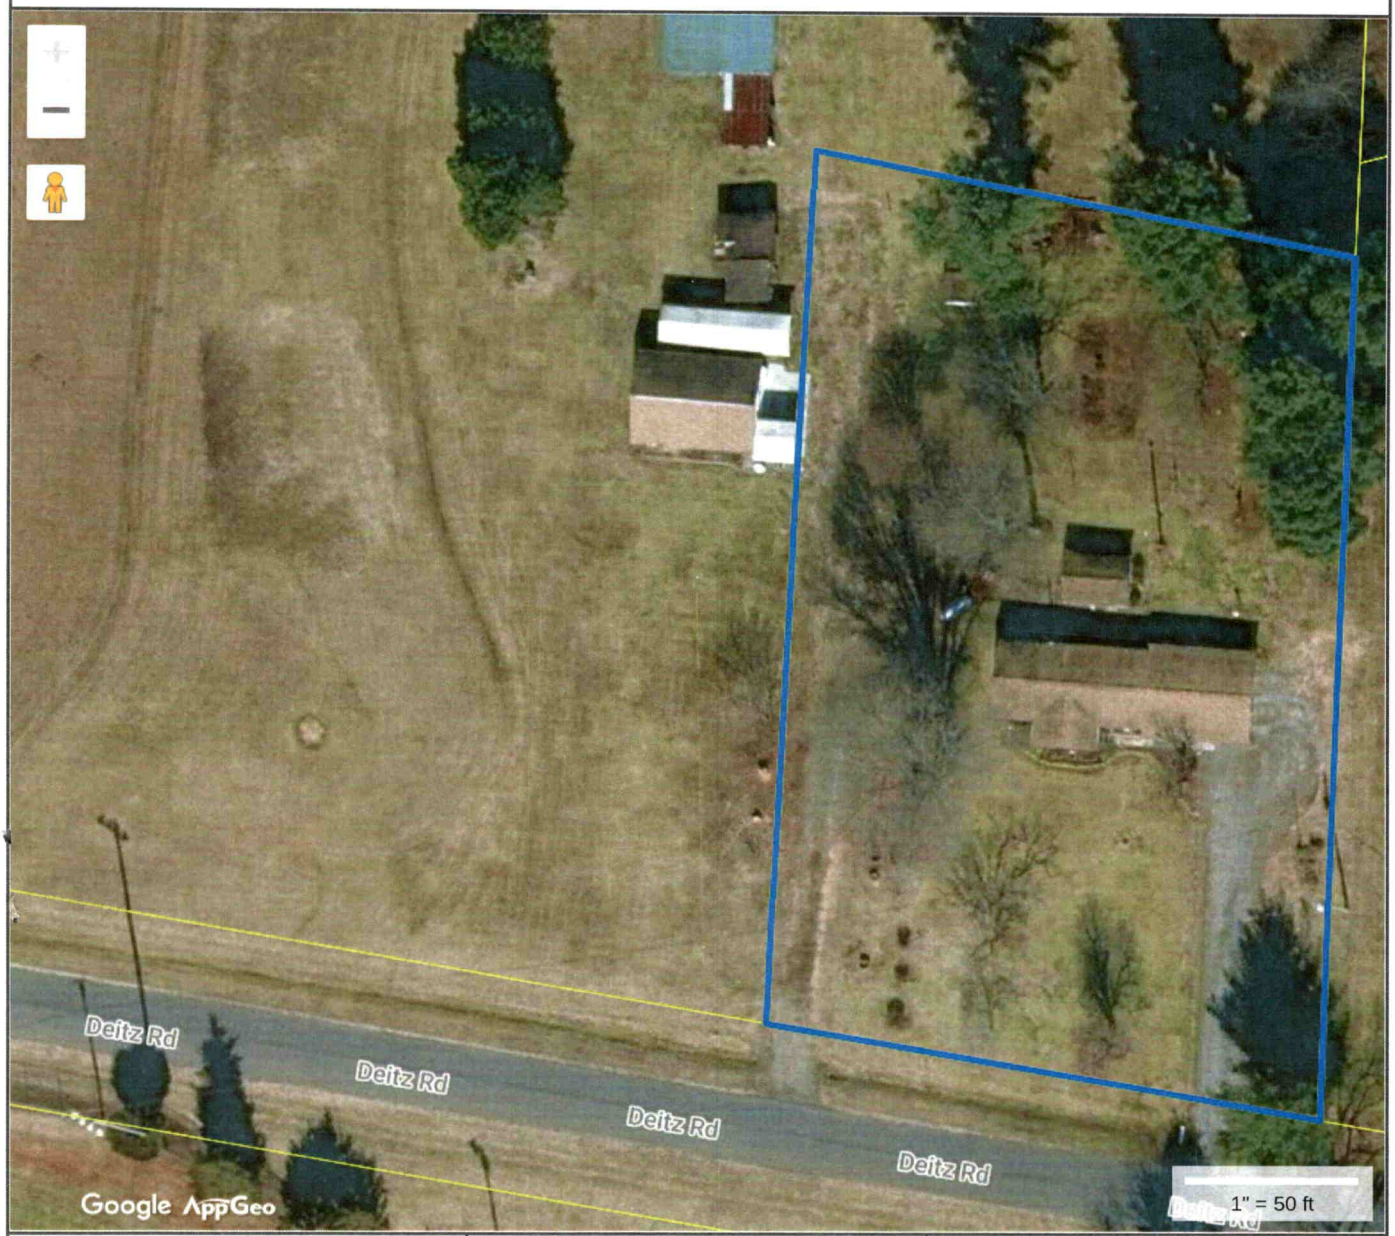

Tax Map Information

• PIN	4747570393.000
• Address	118 DEITZ RD
• Account #	Acct 80102829
• Tax Owner	TAYLOR CAROLYN M
• Mailing Address	118 DEITZ RD
•	STATESVILLE, NC 28625
• GIS Owner	TAYLOR CAROLYN M+REX E MAHAFFEY
• Deed Info	2997 / 197 - WD - 20230609
• Tax Acres	1 AC
• Lot #	
• Description	FRYE SR1913 1 AC
• Zoning	RA
• Old Parcel #	1110L00000A026
• Bldg Value	$65,720
• OBXF Value	$2,990
• Land Value	$30,010
• Total Value	$98,720
• Defer Value	$0
• Tax Districts	-ALLCNTY FIRE- -

IREDELL COUNTY NC

MAP FOR REFERENCE ONLY
NOT A LEGAL DOCUMENT

Iredell County, North Carolina makes no claims and no warranties, expressed or implied, concerning the validity or accuracy of the GIS data presented on this map.

Geometry updated 10/11/2023
Data updated 10/11/2023

Print map scale is approximate. Critical layout or measurement activities should not be done using this resource.

RECEIPT (REC-016346-2023)
FOR IREDELL COUNTY

BILLING CONTACT
CAROLYN & REX MCHAFFEY

Payment Date: 10/13/2023

Reference Number	Fee Name	Transaction Type	Payment Method	Amount Paid
OSWP-2023-35267	Existing System Septic Repair Permit	Fee Payment	Check #4635	$150.00
118 Deitz Rd Statesville, NC 28625			**SUB TOTAL**	**$150.00**
			TOTAL	**$150.00**